	SYMBOL	DESCRIPTION	N					
HVAC	PIPING							
	HWS	HOT WATER	SUPPLY					
	HWR	HOT WATER	HOT WATER RETURN					
	—TWS———	TEMPERED V	VATER SUF	PPLY				
	CWS	CHILLED WA	TER SUPPL	Y				
	CWR	CHILLED WA	TER RETUR	RN				
		REFRIGERAN	IT LIQUID					
	RS	REFRIGERAN	IT SUCTION	J				
		CONDENSER	WATER SU	JPPLY				
		CONDENSER	WATER RE	ETURN				
	D	DRAIN LINE						
	—— (E) ———	EXISTING PIF	ΡE					
41111111	/////.(E) [·] ////////////////////////////////////	EXISTING PIF	PE TO BE R	EMOVED				
	AB	BREV	ΊΑΤΙ	ONS				
	NOTE: AI	L ABBREVIAT	IONS MAY	NOT BE USED				
AD AIR	ACCESS DOOR AIR CONDITION(-	-INGED)	MCA MFR	MINIMUM CIRCUIT AMPS MANUFACTURER				
COND APD	AIR PRESSURE [. ,	MIN N/A	MINIMUM NOT APPLICABLE				
BD BHP	BALANCING DAN BRAKE HORSE P		NC NC	NORMALLY CLOSED NOISE CRITERIA				
BTU BTUH	BRITISH THERMA BTU/HOUR	AL UNIT	NIC NO	NOT IN CONTRACT NORMALLY OPEN				
CFH CFM	CUBIC FEET PER CUBIC FEET PER		NPSH NTS	NET POSITIVE SUCTION HE NOT TO SCALE				
CLG COMP	COOLING		OA OD	OUTSIDE AIR OUTSIDE DIAMETER				
COND	CONDENS(-ER, -		oz	OUNCE				
CV CW	CONTROL VALVE COLD WATER	Ξ	PD PG	PRESSURE DROP OR DIFF. PROPYLENE GLYCOL				
DIA DISCH	DIAMETER DISCHARGE		PH PPM	PHASE PARTS PER MILLION				
DP DB	DEPTH OR DEEP DRY BULB TEMP		PRESS PSF	PRESSURE POUNDS PER SQUARE FOO				
(E) EER	EXISTING ENERGY EFFICIE		PSI PSIA	POUNDS PER SQUARE INCH PSI ABSOLUTE				
EFF	EFFICIENCY		PSIG	PSI GAUGE				
EG ELEC	ETHYLENE GLYC	JOL	R RA	THERMAL RESISTANCE RETURN AIR				
ELEV ENT	ELEVATION ENTERING		RECIRC REFR	RECIRCULATE REFRIGERATION				
EVAP EWT	EVAPORAT(-E, -II ENTERING WATE		REQD RPM	REQUIRED REVOLUTIONS PER MINUTE				
EXT (F)	EXTERNAL FUTURE		RW SA	RAINWATER SUPPLY AIR				
F	FAHRENHEIT		SC	SHADING COEFFICIENT				
FC FD	FLEXIBLE CONNI FIRE DAMPER		SCW SF	SOFT COLD WATER SAFETY FACTOR				
FLA FPI	FULL LOAD AMPS	5	SH SL	SENSIBLE HEAT SEA LEVEL				
FPM FPS	FEET PER MINUT FEET PER SECO		SP SPEC(S)	STATIC PRESSURE SPECIFICATION(S)				
FSD FT	FIRE SMOKE DAN	MPER	SQ STD	SQUARE STANDARD				
GAL GPH	GALLON(S) GALLONS PER H		TEMP TSTAT	TEMPERATURE				
GPM	GALLONS PER M		V	VOLT				
HD HG	HEAD MERCURY		VAC VAV	VACUUM VARIABLE AIR VOLUME				
HR HT	HOUR HEIGHT		VEL VENT	VELOCITY VENT, VENTILATION				
HTG HP	HEATING HORSE POWER		VFD WC	VARIABLE FREQUENCY DR				
HW HZ	HOT WATER HERTZ(FREQUE)		WG WPD	WATER GAUGE WATER PRESSURE DROP				
ID	INSIDE DIAMETE		WB	WET BULB				
IN KW	INCH KILOWATT							
LAT LBS	LEAVING AIR TEN POUNDS	MPERATURE						
LG LH	LENGTH LATENT HEAT							
LRA LVG	LOCKED ROTOR LEAVING	AMPS						
LWT MBH	LEAVING WATER THOUSAND BTU							
	D	EFINI		NS				
	NOTE: ALL	DEFINITIO	NS MAY	NOT BE USED.				
				REPRESENTATIONS, NOTES, OR SCHEDULES IN THE SPECIFICATIC				

 $-\overline{\mathsf{A}}$ GATE VALVE CHECK VALVE AUTO 2-WAY VALVE AUTO 3-WAY VALVE GLOBE VALVE BALL VALVE RELIEF VALVE CHAIN OPERATED GATE VALVE \triangleleft PRESSURE REDUCING VALVE $-\bowtie$ BUTTERFLY VALVE S SOLENOID VALVE -1×1-ANGLE VALVE VENTURI BALANCING OR PLUG COCK $- \swarrow$ FLOW SETTER $-\otimes$ -EXPANSION VALVE (REFRIG.) (T)TEMPERATURE SENSOR ¥маv MANUAL AIR VENT STRAINER GAUGE COCK -FLEXIBLE CONNECTION \odot PRESSURE GAUGE THERMOMETER VICTAULIC COUPLING _∏_ REDUCER CONCENTRIC _____D___ REDUCER ECCENTRIC ______ REFRIGERANT SITE GLASS _∰_ REFRIGERANT STRAINER REFRIGERANT FILTER DRIER $-\bigcirc$ 90° ELBOW UP \bigcirc 90° ELBOW DOWN $-\bigcirc -$ 90° TEE UP \frown 90° TEE DOWN $\overline{\bigcirc}$ UNION CAPPED PIPE ANCHOR $\neg \Box \neg$ FLOAT AND THERMOSTATIC TRAP HVAC SYMBOLS (T) THERMOSTAT (s)TEMPERATURE SENSOR (H)HUMIDISTAT PLUMBING SYMBOLS С.В. CATCH BASIN ○ м.н. MANHOLE WALL HYDRANT ------ W.H. —____ Н.В. HOSE BIBB —Ф CLEANOUT TO GRADE --Φ FLOOR CLEANOUT

WALL CLEANOUT

SYMBOL LEGEND

DESCRIPTION

SHUT OFF VALVE

VALVES, METERS, AND GAUGES

SYMBOL

 \longrightarrow

INSTALLER: AN "INSTALLER" IS THE CONTRACTOR OR AN ENTITY ENGAGED BY THE CONTRACTOR, EITHER AS AN EMPLOYEE, SUBCONTRACTOR, OR SUB-SUBCONTRACTOR, FOR PERFORMANCE OF A PARTICULAR CONSTRUCTION ACTIVITY, INCLUDING INSTALLATION. ERECTION, APPLICATION, AND SIMILAR OPERATIONS. INSTALLERS ARE REQUIRED TO BE EXPERIENCED IN THE OPERATIONS THEY ARE ENGAGED TO PERFORM.

ANCHORING, APPLYING, WORKING TO DIMENSION, FINISHING, CURING, PROTECTING, CLEANING,

PROVIDE: THE TERM "PROVIDE" MEANS "TO FURNISH AND INSTALL, COMPLETE AND READY FOR

APPROVE: THE TERM "APPROVED", WHERE USED IN CONJUNCTION WITH THE ENGINEER'S ACTION ON THE CONTRACTOR'S SUBMITTALS, APPLICATIONS, AND REQUESTS, IS LIMITED TO

FURNISH: THE TERM "FURNISH" IS USED TO MEAN "SUPPLY AND DELIVER TO THE PROJECT

SITE, READY FOR UNLOADING, UNPACKING, ASSEMBLY, INSTALLATION, AND SIMILAR

INSTALL: THE TERM "INSTALL" IS USED TO DESCRIBE OPERATIONS AT PROJECT SITE

INCLUDING THE ACTUAL "UNLOADING, UNPACKING, ASSEMBLY, ERECTION, PLACING,

AND SIMILAR OPERATIONS TO MAKE THE ITEM FULLY OPERATIONAL."

THE ENGINEER'S DUTIES AND RESPONSIBILITIES AS STATED IN GENERAL AND SUPPLEMENTARY

CONDITIONS.

OPERATIONS."

THE INTENDED USE."

	MBOL LEGE	ND
SYMBOL DUCTWORK	DESCRIPTION	
SINGLE LINE	DOUBLE LINE	DESCRIPTION
		RECTANGULAR SUPPLY DUCT UP
		RECTANGULAR SUPPLY DUCT DOWN
2		RECTANGULAR RETURN DUCT UP
<u>}</u>		RECTANGULAR RETURN DUCT DOWN
2		RECTANGULAR EXHAUST DUCT UP
2		RECTANGULAR EXHAUST DUCT DOWN
		ROUND DUCT UP
		ROUND DUCT DOWN
		ACOUSTICALLY LINED RECTANGULAR DUCT
2		90° RECTANGULAR ELBOW WITH TURNING VANES
2		90° RADIUS ELBOW R=1.5
→ → → →		DUCT SIZE OR SHAPE TRANSITION
₹{		OPPOSED BLADE BALANCING DAMPER (O.B.D.) IN RECT DUCT
<u>۲</u>		BUTTERFLY BALANCING DAMPER IN ROUND DUCTS
2		COMBINATION TEE
<u>}</u>		SPLITTER DAMPER
		SQUARE OR RECTANGULAR CEILING DIFFUSER
		ROUND CEILING DIFFUSER
		SIDEWALL REGISTER SUPPLY OR RETURN
		ROUND FLEXIBLE DUCT
		RETURN GRILLE
		EXHAUST GRILLE
		FIRE/SMOKE DAMPER
FSD FD FD	FSD FSD	FIRE DAMPER
→ → → → → → → → → → → → → → → → → → →		FLEXIBLE CONNECTION
<u>}</u>	FC	EXISTING DUCT
₹ <i>1111111111111</i> 2		DUCT TO BE REMOVED

GENERAL MECHANICAL NOTES

1. ALL CEILING DIFFUSERS SHOWN AS SUCH ARE CD-1, CFM AS NOTED, UNLESS OTHERWISE NOTED. CFM

- 2. ALL CEILING RETURN GRILLES SHOWN AS SUCH ARE RG-1 UNLESS OTHERWISE NOTED. PROVIDE SOUND BOOT
- 3. ALL CEILING EXHAUST GRILLES SHOWN AS SUCH ARE EG-1, CFM AS NOTED, UNLESS OTHERWISE NOTED.

CFM

- 4. DO NOT ROUTE DUCTS AND PIPES ABOVE ELECTRICAL PANELS. ALL ELECTRICAL PANELS MUST HAVE CLEAR ACCESS SPACE IN FRONT OF PANEL 4'-0" DEEP AND 6'-6" HIGH. DO NOT ROUTE DUCTS AND PIPES IN ELECTRICAL ROOMS, EXCEPT DUCTS AND PIPES SERVING THE ROOM OR WITHIN APPROPRIATE ENCLOSURE.
- 5. COORDINATE EXACT LOCATIONS OF CEILING DIFFUSERS AND GRILLES WITH ARCHITECTURAL REFLECTED CEILING PLANS.
- 6. ALL DUCT DIMENSIONS ARE INSIDE FREE AREA DIMENSIONS. ADJUST SHEET METAL DIMENSION FOR LINED DUCT.
- 7. ALL FIRE DAMPERS SHOWN ARE 1-1/2 HOUR UNLESS OTHERWISE NOTED.
- 8. IF CONTRACTOR ENCOUNTERS MATERIAL WHICH MAY CONTAIN ASBESTOS IMMEDIATELY STOP WORK IN THIS AREA AND NOTIFY THE OWNER.
- 9. PROVIDE CEILING ACCESS PANELS AS REQUIRED WHERE MECHANICAL EQUIPMENT, VALVES, HEAT PUMPS, FIRE DAMPERS, ETC. ARE LOCATED ABOVE INACCESSIBLE CEILINGS. ACCESS PANELS TO BE LISTED AND FIRE RATED EQUAL TO OR GREATER THAN THE RATING OF THE ASSEMBLY THEY ARE INSTALLED IN.
- 10. ALL DUCT AND FLUE PENETRATIONS THRU 1 HOUR ROOF ASSEMBLY TO BE ENCLOSED WITH 2 SHEET ROCK LAYERS FROM SHEET ROCK AT BOTTOM OF ROOF TRUSSES TO ROOF DECK.
- 11. STEEL ROOF DECK SHALL NOT BE USED TO SUPPORT LOADS FROM PIPING, DUCTWORK OR EQUIPMENT, UNLESS NOTED OTHERWISE. HANGER LOADS LESS THAN 50 LBS. MAY BE HUNG FROM THE STEEL ROOF DECK IN CASES WHEN HANGING FROM THE STEEL ROOF DECK CANNOT BE AVOIDED; THE ATTACHMENT METHOD MUST DISTRIBUTE THE LOAD ACROSS THE DECK AS APPROVED BY THE STRUCTURAL ENGINEER.
- 12. THE EQUIPMENT INSTALLER IS TO APPLY AND SIGN A CERTIFICATION LABEL TO EACH GAS-FIRED APPLIANCE, STATING THE APPLIANCE HAS BEEN ADJUSTED OR MODIFIED PER MANUFACTURER'S REQUIREMENTS FOR OPERATION AT THE PROJECT ALTITUDE AND WITH THE BTU-CONTENT OF THE AVAILABLE FUEL-GAS.

SYN	MBOL LEGEND
SYMBOL	DESCRIPTION
REFERE	NCE AND LINE SYMBOLS
# SHEET	DETAIL INDICATOR: # INDICATES DETAIL NUMBI SHEET INDICATES DRAWING SHEET WHERE DE SHOWN.
# SHEET	ELEVATION OR SECTION INDICATOR, EXTERIOR INDICATES ELEVATION OR SECTION NUMBER, S INDICATES DRAWING SHEET WHERE ELEVATION SECTION IS SHOWN.
# SHEET	ELEVATION OR SECTION INDICATOR, INTERIOR: INDICATES ELEVATION OR SECTION NUMBER, S INDICATES DRAWING SHEET WHERE ELEVATION SECTION IS SHOWN.
TYPE CFM SIZE	DIFFUSER/GRILLE INDICATOR.
TYPE SIZE	DIFFUSER/GRILLE INDICATOR.
•	NEW CONNECTION POINT TO EXISTING

MECHANICAL SCOPE OF WORK

NEW CONSTRUCTION NOTES:

ELECTRIC UNIT HEATERS WILL BE PLACED WATER ENTRY ROOMS AND MAIN BUILDING ENTRY LOCATIONS.

ROOFTOP UNITS ARE TO BE INSTALLED WITHIN EXISTING EQUIPMENT WELLS ON ROOF OF EACH BUILDING. SUPPLY AND RETURN DUCTWORK IS TO ROUTE THROUGH EXISTING TRUSS SYSTEM. TERMINAL SUPPLY AND RETURN GRILLES ARE TO INCORPORATE INTEGRAL BALANCING DAMPERS.

CLOTHES DRYER AND BATHROOM EXHAUST DUCTWORK IS TO TERMINATE AT UNDERSIDE OF EXISTING BUILDING OVERHANGS.

THE NEW SYSTEM COMPONENTS WILL ALLOW FOR FUTURE OFFICE & TEMPORARY RESIDENT SPACES.

NUMBER, ERE DETAIL IS

TERIOR: # IBER, SHEET VATION OR

ERIOR: # IBER, SHEET EVATION OR

ME	MECH/PLUMB SHEET INDEX							
SHEET NO	SHEET TITLE							
M01	MECHANICAL GENERAL NOTES & LEGEND							
M02	MECHANICAL EQUIPMENT SPECIFICATIONS							
M11	MECHANICAL SCHEDULES							
M12	MECHANICAL DETAILS							
M13	MECHANICAL DETAILS							
P01	PLUMBING GENERAL NOTES & LEGEND							
P02	PLUMBING EQUIPMENT SPECIFICATIONS							
P11	PLUMBING SCHEDULES							
P12	PLUMBING DETAILS							
P13	PLUMBING DETAILS							
MP1B	MECH/PLUMB ROOF PLAN - BUILDING 'B'							
M1B	MECHANICAL PLAN - BUILDING 'B'							
P1B	PLUMBING PLAN - BUILDING 'B'							



GENERAL MECHANICAL NOTES

- THESE DRAWINGS AND SPECIFICATIONS ARE FOR THE DIVISION 23 CONTRACTOR TO ENGINEER. DESIGN. BID AND INSTALL A HEATING, AIR CONDITIONING AND VENTILATION SYSTEM PER THE DESIGN INTENT SHOWN.
- ALL EQUIPMENT, PIPING, DUCTWORK, COMPONENT AND ACCESSORY SIZES, CAPACITIES, AND TYPES SHOWN IN THESE DRAWINGS AND SPECIFICATIONS SHALL BE ADHERED TO.
- THE DIVISION 23 CONTRACTOR SHALL DESIGN AND INSTALL A COMPLETE AND FULLY OPERATIONAL SYSTEM.
- DESIGN AND AS-BUILT DRAWINGS SHOWING ALL EQUIPMENT, COMPONENTS, PIPING, AND CONTROLS SHALL BE PREPARED TO THE SAME SCALE AS THESE DRAWINGS. COPIES SHALL BE PROVIDED TO THE OWNER AND ARCHITECT/ENGINEER
- PROVIDE ALL LABOR, MATERIALS, AND EQUIPMENT NECESSARY TO CONSTRUCT A COMPLETE, OPERATIONAL HVAC SYSTEM FOR THE ENTIRE PROJECT AS SHOWN ON THESE DRAWINGS, INCLUDING ALL NECESSARY FEES AND PERMITS.
- THE ENTIRE INSTALLATION SHALL CONFORM TO THE REQUIREMENTS OF THE MOST RECENTLY ADOPTED BUILDING CODE, MECHANICAL CODE, PLUMBING CODE, ELECTRICAL CODE, AND ALL OTHER APPLICABLE CITY, COUNTY, SCHOOL DISTRICT, STATE, AND FEDERAL CODES AND REGULATIONS IN EFFECT AT THE DATE OF THE BID. CONFORM TO ANY CODES, RULES, REGULATIONS AND REQUIREMENTS THAT THE PROJECT OWNER HAS.
- PRIOR TO FABRICATION AND INSTALLATION, COORDINATE THE INSTALLATION OF ALL HVAC PIPING, DUCTWORK, AND EQUIPMENT WITH PLUMBING PIPING, PLUMBING EQUIPMENT, REFRIGERATION TRENCHES AND PIPING, FIRE PROTECTION PIPING AND ALL OTHER TRADES INCLUDING BUT NOT LIMITED TO: THE MECHANICAL CONTRACTOR, REFRIGERATION CONTRACTOR, ELECTRICAL CONTRACTOR, FIRE PROTECTION CONTRACTOR, GENERAL CONTRACTOR, AND ANY CONTRACTOR HIRED DIRECTLY BY THE OWNER. WHERE CONFLICTS MAY OCCUR, THEY SHALL BE RESOLVED PRIOR TO INSTALLATION.
- THE DRAWINGS SHOW THE GENERAL DESIGN, ARRANGEMENTS AND THE EXTENT OF THE SYSTEM. IT SHALL BE THE WORK OF THE CONTRACTOR TO MAKE SUCH SLIGHT ALTERATIONS AS MAY BE NECESSARY TO MAKE THE SYSTEM COMPLETE AND OPERATIONAL IN ACCORDANCE WITH THE DESIGN INTENT. MAJOR DEVIATIONS SUCH AS CHANGES IN COMPONENT SIZES, WEIGHTS, QUANTITIES, OR MATERIAL REQUIRE PRIOR APPROVAL BY THE CONSULTING ENGINEER.
- ALL HVAC INFORMATION IS NOT SHOWN ON THE HVAC DRAWINGS. THE CONTRACTOR SHALL BE RESPONSIBLE FOR COORDINATING INFORMATION ON ALL OTHER CONSTRUCTION DOCUMENTS INCLUDING ARCHITECTURAL, STRUCTURAL, MECHANICAL, PLUMBING, AND ELECTRICAL DRAWINGS.
- 10. THE WORKING DRAWINGS ARE DIAGRAMMATIC. BECAUSE OF THE SMALL SCALE OF THE DRAWINGS, THEY DO NOT SHOW EVERY OFFSET, BEND OR ELBOW NECESSARY FOR THE COMPLETE INSTALLATION IN THE SPACE PROVIDED. ALL LOCATIONS FOR HVAC EQUIPMENT AND PIPING SHALL BE CHECKED AND COORDINATED WITH THE ARCHITECTURAL, MECHANICAL, STRUCTURAL AND ELECTRICAL DRAWINGS.
- SPACE ABOVE ALL CEILINGS IS LIMITED. CAREFUL COORDINATION IS REQUIRED WITH ALL TRADES BEFORE ANY PIPE, DUCT, OR EQUIPMENT IS ORDERED AND/OR INSTALLED, ANY CONFLICTS AND/OR CHANGES FOUND DURING INSTALLATION THAT RESULT FROM LACK OF COORDINATION BY THE CONTRACTORS DURING THE SHOP DRAWING PROCESS ARE THE RESPONSIBILITY OF THE CONTRACTOR.
- 12. 1/8" SCALE SHOP DRAWINGS (SUBMITTED FOR APPROVAL) ARE REQUIRED FOR ALL DUCTWORK AND PIPING SYSTEMS.
- 13. THE DRAWINGS AND SPECIFICATIONS HAVE BEEN PREPARED TO SUPPLEMENT EACH OTHER AND THEY SHALL BE INTERPRETED AS AN INTEGRAL UNIT WITH THE ITEMS SHOWN ON ONE AND NOT THE OTHER BEING FURNISHED AND INSTALLED AS THOUGH SHOWN AND CALLED OUT IN BOTH.
- 14. DETAILS: THE CONTRACTOR IS RESPONSIBLE TO REVIEW AND USE WHERE APPROPRIATE ALL OF THE MECHANICAL DETAILS SHOWN ON THE DRAWINGS. DETAILS MAY OR MAY NOT BE CALLED OUT ON THE DRAWINGS WITH SYMBOLS OR KEYED NOTES. ANY CHANGES RESULTING FROM FAILURE TO INSTALL THE MECHANICAL SYSTEM WITHOUT USING THE INCLUDED DETAILS IS THE RESPONSIBILITY OF THE CONTRACTOR.
- 15. PIPING SCHEMATICS: THE CONTRACTOR IS RESPONSIBLE TO REVIEW THE PIPING SCHEMATICS INCLUDED WITH THE DRAWINGS FOR PIPING CONNECTIONS TO ALL MECHANICAL EQUIPMENT. THE PIPING SCHEMATICS SHOW DETAILED CONNECTIONS INCLUDING NECESSARY VALVES, FITTINGS, PRESSURE AND TEMPERATURE GAUGES, ETC., THAT ARE NOT SHOWN ON THE PIPING PLANS. ANY CHANGES RESULTING FROM FAILURE TO INSTALL THE MECHANICAL SYSTEM WITHOUT USING THE INCLUDED PIPING SCHEMATICS IS THE RESPONSIBILITY OF THE CONTRACTOR.
- THE STRUCTURE SHOWN ON ALL DETAILS MAY OR MAY NOT PERTAIN TO A PORTION OR ANY PORTION OF THE BUILDING. COORDINATE MOUNTING REQUIREMENTS WITH ARCHITECTURAL AND STRUCTURAL DRAWINGS.
- ANY PART OF THIS INSTALLATION THAT FAILS, IS UNFIT, OR BECOMES DAMAGED DURING CONSTRUCTION SHALL BE REPAIRED OR REPLACED BY THE CONTRACTOR AT NO ADDITIONAL COST TO THE OWNER.
- 18. COORDINATE THE RETURN OF ALL MECHANICAL EQUIPMENT REMOVED DURING DEMOLITION WITH THE OWNER'S REPRESENTATIVE.
- 19. ALL EQUIPMENT SHALL PROVIDE THE SCHEDULED PERFORMANCE AT THE SITE ALTITUDE.
- 20. ALL EQUIPMENT SHALL BE INSTALLED IN STRICT ACCORDANCE WITH THE EQUIPMENT MANUFACTURER'S RECOMMENDATIONS. PROVIDE ALL FITTINGS. TRANSITIONS, VALVES, DAMPERS, AND OTHER DEVICES AND ACCESSORIES REQUIRED FOR A COMPLETE, WORKABLE INSTALLATION.
- THE DIVISION 23 CONTRACTOR SHALL FURNISH ALL REQUIRED MOTORS. ALL MOTOR STARTING EQUIPMENT, WHEN NOT A PART OF THE EQUIPMENT, WILL BE FURNISHED BY THE ELECTRICAL CONTRACTOR.
- 22. EXISTING INTERIOR PIPING, EQUIPMENT, AND DUCTWORK HAS BEEN LOCATED IN AN APPROXIMATE WAY ONLY. THE CONTRACTOR SHALL VERIFY LOCATIONS AND POINTS OF CONNECTION AND PIPE ROUTING THROUGH EXISTING CONDITIONS PRIOR TO COMMENCING WORK. THE CONTRACTOR SHALL PERFORM THE WORK IN A MANNER THAT WILL CAUSE A MINIMUM DISRUPTION TO BUILDING TENANT USE AND SHALL COORDINATE THE WORK WITH THE BUILDING OWNER'S REPRESENTATIVE.
- 23. THE CONTRACTOR IS RESPONSIBLE FOR HVAC EQUIPMENT CHECK-IN, SAFEKEEPING, AND DAMAGE
- 24. DO NOT ROUTE DUCTS AND PIPES ABOVE ELECTRICAL PANELS. ALL ELECTRICAL PANELS MUST HAVE CLEAR ACCESS SPACE IN FRONT OF PANEL 4'-0" DEEP AND 6'-6" HIGH. DO NOT ROUTE DUCTS AND PIPES IN FLECTRICAL ROOMS, EXCEPT DUCTS AND PIPES SERVING THE ROOM OR IF PROPER ENCLOSURE IS PROVIDED
- 25. COORDINATE EXACT LOCATIONS OF CEILING DIFFUSERS AND GRILLES WITH ARCHITECTURAL REFLECTED CEILING PLAN.
- 26. ALL FIRE DAMPERS SHOWN ARE 1-1/2 HOUR UNLESS OTHERWISE NOTED. 27. IF CONTRACTOR ENCOUNTERS MATERIAL WHICH MAY CONTAIN ASBESTOS, IMMEDIATELY STOP WORK IN THIS AREA AND NOTIFY THE OWNER.
- 28. PROVIDE CEILING ACCESS PANELS AS REQUIRED WHERE MECHANICAL EQUIPMENT, VALVES, VAV BOXES, FIRE DAMPERS, ETC. ARE LOCATED ABOVE INACCESSIBLE CEILINGS.
- 29. ENCLOSE ALL DUCT AND FLUE PENETRATIONS THROUGH 1 HOUR ROOF ASSEMBLIES WITH 2 SHEET ROCK LAYERS FROM SHEET ROCK CEILING AT BOTTOM OF ROOF TRUSSES TO ROOF DECK
- 30. DO NOT USE STEEL ROOF DECK TO SUPPORT LOADS FROM PIPING, DUCTWORK OR EQUIPMENT. HANGER LOADS LESS THAN 50 LBS. MAY BE HUNG FROM THE STEEL ROOF DECK IN CASES WHERE HANGING FROM THE STEEL ROOF DECK CANNOT BE AVOIDED. THE ATTACHMENT METHOD MUST DISTRIBUTE THE LOAD ACROSS THE DECK AS APPROVED BY THE STRUCTURAL ENGINEER.

GENERAL MECHANICAL NOTES

- 1. PROPERLY LUBRICATE ALL PIECES OF EQUIPMENT BEFORE TURNING THE SYSTEM OVER TO THE OWNER.
- 2. PREPARE SUBMITTALS IN AN INDEXED, LABELED FOLDER CONTAINING FULL PERFORMANCE, MATERIAL AND INSTALLATION INFORMATION ABOUT ALL EQUIPMENT, PIPING, COMPONENTS AND ACCESSORIES TO BE USED. SUBMITTALS WILL BE CHECKED AT MOST TWICE. TIME SPENT ON SUBSEQUENT SUBMITTALS WILL BE BILLED TO THE CONTRACTOR BY THE ENGINEER AT ITS CURRENT HOURLY RATES.
- 3. TWO OPERATING AND MAINTENANCE MANUALS SHALL BE PROVIDED IN HARD BACK LOOSE LEAF BINDERS. MANUALS SHALL CONTAIN PRODUCT CUT SHEETS AND OPERATING AND MAINTENANCE INSTRUCTIONS ON ALL EQUIPMENT, ACCESSORIES, FIXTURES, VALVES, ETC., PROVIDED FOR THE PROJECT.
- 34. UPON COMPLETION OF THE WORK, REMOVE ALL SURPLUS MATERIALS AND RUBBISH. MAKE ALL REQUIRED PATCHING AND REPAIRS OF OTHER TRADES' WORK DAMAGED BY THE CONTRACTOR, AND LEAVE THE PREMISES IN A CLEAN, ORDERLY CONDITION.
- . THE CONTRACTOR SHALL OPERATE THE SYSTEM AND DEMONSTRATE ALL ASPECTS TO THE ENGINEER AND/OR OWNER, TO PROVE ITS OPERATION. ALL FILTERS USED DURING CONSTRUCTION SHALL BE REPLACED PRIOR TO THE TEST RUN PERIOD
- . THE CONTRACTOR SHALL GUARANTEE THE HVAC SYSTEM FOR A PERIOD OF ONE YEAR FROM THE DATE OF SUBSTANTIAL COMPLETION.
- . THE CONTRACTOR SHALL, DURING CONSTRUCTION, MAINTAIN A SET OF AS-BUILT REDUNED RECORD DRAWINGS AT THE PROJECT SITE ALL CHANGES IN LAYOUT ROUTING, EQUIPMENT, COMPONENTS, AND ACCESSORIES SHALL BE RECORDED. THESE REDLINES SHALL BE GIVEN TO THE ARCHITECT/ENGINEER AFTER THE FINAL INSPECTION

MECHANICAL SUBMITTAL NOTES

MECHANICAL SUBMITTAL SHALL BE SUBMITTED AS A COMPLETE ELECTRONIC PACKAGE ASSEMBLED BY SPECIFICATION DIVISIONS.

ASSEMBLE COMPLETE ELECTRONIC SUBMITTAL PACKAGE INTO A SINGLE INDEXED FILE INCORPORATING SUBMITTAL REQUIREMENTS OF A SINGLE SPECIFICATION SECTION AND TRANSMITTAL FORM WITH LINKS ENABLING NAVIGATION TO EACH ITEM:

- a. LITERATURE SHALL INCLUDE REFERENCE TO EQUIPMENT CALL-OUT AND SPECIFICATION SECTION.
- b. FILE NAME SHALL USE PROJECT IDENTIFIER AND SPECIFICATION SECTION NUMBER FOLLOWED BY A DECIMAL POINT AND THEN A SEQUENTIAL NUMBER (E.G., LNHS-061000.01), RE-SUBITTALS SHALL INCLUDE AN ALPHABETIC SUFFIX AFTER ANOTHER DECIMAL POINT (E.G., INHS-061000.01.A).
- c. PROVIDE MANUFACTURER'S CATALOG DATA SHEETS FOR EACH MANUFACTURED ITEM LISTED ON THE DRAWINGS AND SPECIFICATIONS.
- d. INCLUDE MANUFACTURER'S CATALOG DATA OF EACH MANUFACTURED ITEM AND ENOUGH INFORMATION TO SHOW COMPLIANCE WITH CONTRACT DOCUMENT REQUIREMENTS.
- e. LITERATURE SHALL SHOW CAPACITIES AND SIZE OF EQUIPMENT USED AND BE MARKED INDICATING EACH SPECIFIC ITEM WITH APPLICABLE DATA UNDERLINED.
- . INCLUDE NAME, ADDRESS, AND PHONE NUMBER OF EACH SUPPLIER.
- g. DEVIATIONS AND ADDITIONAL INFORMATION: ON AN ATTACHED SEPARATE SHEET, PREPARED ON CONTRACTOR'S LETTERHEAD, RECORD RELEVANT INFORMATION, REQUESTS FOR DATA, REVISIONS OTHER THAN THOSE REQUESTED BY ENGINEER CONTRACT DOCUMENTS, INCLUDING MINOR VARIATIONS AND LIMITATIONS. INCLUDE SAME IDENTIFICATION INFORMATION AS RELATED SUBMITTAL

PRODUCT DATA:

- a. COLLECT INFORMATION INTO A SINGLE SUBMITTAL FOR EACH ELEMENT OF CONSTRUCTION AND TYPE OF PRODUCT OR EQUIPMENT.
- b. IF INFORMATION MUST BE SPECIALLY PREPARED FOR SUBMITTAL BECAUSE STANDARD PUBLISHED DATA ARE NOT SUITABLE FOR USE. SUBMIT AS SHOP DRAWINGS, NOT AS PRODUCT DATA.
- c. MARK EACH COPY OF EACH SUBMITTAL TO SHOW WHICH PRODUCTS AND OPTIONS ARE APPLICABLE.
- d. INCLUDE THE FOLLOWING INFORMATION, AS APPLICABLE:
- e. MANUFACTURER'S CATALOG CUTS.
- f. MANUFACTURER'S PRODUCT SPECIFICATIONS.
- g. STANDARD COLOR CHARTS.
- h. STATEMENT OF COMPLIANCE WITH SPECIFIED REFERENCED STANDARDS.
- i. TESTING BY RECOGNIZED TESTING AGENCY.
- j. APPLICATION OF TESTING AGENCY LABELS AND SEALS.
- k. NOTATION OF COORDINATION REQUIREMENTS.
- I. AVAILABILITY AND DELIVERY TIME INFORMATION.
- m. FOR EQUIPMENT, INCLUDE THE FOLLOWING IN ADDITION TO THE ABOVE, AS APPLICABLE:
- n. WIRING DIAGRAMS SHOWING FACTORY-INSTALLED WIRING.
- o. PRINTED PERFORMANCE CURVES.
- p. OPERATIONAL RANGE DIAGRAMS.

SUBMITTAL.

q. CLEARANCES REQUIRED TO OTHER CONSTRUCTION, IF NOT INDICATED ON ACCOMPANYING SHOP DRAWINGS.

PROCESSING TIME: ALLOW TIME FOR SUBMITTAL REVIEW, INCLUDING TIME FOR RESUBMITTALS, AS FOLLOWS. TIME FOR REVIEW, INCLUDING TIME FOR RESUBMITTALS, AS FOLLOWS. TIME FOR REVIEW SHALL COMMENCE ON ENGINEERS RECEIPT OF SUBMITTAL. NO EXTENSION OF THE CONTRACT TIME WILL BE AUTHORIZED BECAUSE OF FAILURE TO TRANSMIT SUBMITTALS ENOUGH IN ADVANCE OF THE WORK TO PERMIT PROCESSING, INCLUDING RESUBMITTALS.

- a. INITIAL REVIEW: ALLOW 15 DAYS FOR INITIAL REVIEW OF MECHANICAL
- b. RESUBMITTALS REVIEW: ALLOW 15 DAYS FOR REVIEW OF EACH

RESUBMITTAL. DEVIATIONS AND ADDITIONAL INFORMATION: ON AN ATTACHED SEPARATE SHEET

PREPARED ON CONTRACTOR'S LETTERHEAD, RECORD RELEVANT INFORMATION. REQUESTS FOR DATA, REVISIONS OTHER THAN THOSE REQUESTED BY DESIGN ENGINEER ON PREVIOUS SUBMITTALS, AND DEVIATIONS FROM REQUIREMENTS IN THE CONTRACT DOCUMENTS. INCLUDING MINOR VARIATIONS AND LIMITATIONS. INCLUDE SAME IDENTIFICATION INFORMATION AS RELATED SUBMITTAL.

MECH. PIPING GENERAL NOTES

CAULK AROUND ALL PIPING THAT PASSES THROUGH FIRE RATED PARTITIONS WITH A NON-HARDENING CAULKING SIMILAR TO 3M "FIRE BARRIER".

PROVIDE PROPER PROVISIONS FOR EXPANSION OR MOVEMENT OF ALL PIPING. PROVIDE LARGE ENOUGH PIPE SLEEVES THROUGH WALLS OR FLOORS TO ALLOW FOR ANTICIPATED DEFERENTIAL MOVEMENTS.

AT VERTICAL RISERS SUPPORT THE WEIGHT OF THE RISER AT A POINT OR POINTS. ABOVE THE CENTER OF GRAVITY OF THE RISER. PROVIDE LATERAL GUIDES AT THE TOP AND BOTTOM OF THE RISER, AND AT THE INTERMEDIATE POINTS NOT TO EXCEED 30'-0" ON CENTER.

ALL PIPING SHALL BE SUPPORTED WITH TYPE I STEEL CLEVIS PIPE HANGERS. ALL STEEL CLEVIS HANGERS USED TO SUPPORT PLASTIC PIPING SHALL BE

PLASTIC COATED. ALL STEEL HANGERS USED TO SUPPORT COPPER PIPING SHALL BE COPPER

PLATED OR PLASTIC COATED. PERFORATED METAL OR PLASTIC STRAPPING (PLUMBERS TAPE) IS NOT AN ACCEPTABLE MATERIAL FOR HANGING OR SECURING PIPE.

PROVIDE PIPE HANGERS WITHIN 18 INCHES OF ALL 90 DEGREE ELBOWS.

PROVIDE SWAY BRACING ON PIPING 4" AND LARGER AT CHANGES IN DIRECTION **GREATER THAN 45 DEGREES.**

ALL PIPING SHALL BE INSTALLED IN A NEAT ARRANGEMENT PARALLEL TO BUILDING STRUCTURE.

DUCT CONSTRUCTION NOTES

ALL DUCTWORK SHALL BE GALVANIZED SHEET METAL, EXCEPT WHERE INDICATED OTHERWISE.

2. SHEET METAL DUCT STATIC PRESSURE CLASSIFICATION: SUPPLY AIR DUCT: 2" W.C. 2" W.C. (NEGATIVE) RETURN AIR DUCT: EXHAUST AIR DUCT: 2" W.C. (NEGATIVE) OUTSIDE AIR DUCT: 2" W.C.

3. SEAL ALL TRANSVERSE JOINTS AND LONGITUDINAL SEAMS TO SMACNA SEAL CLASS B.

- 4. DO NOT USE GRAY DUCT TAPE, FOIL BACKED TAPE, OIL BASED CAULKING AND GLAZING COMPOUNDS TO SEAL METAL DUCTS.
- CROSS-BREAK DUCT SURFACES 19" THROUGH 60". USE ANGLE REINFORCING FOR DUCTS SURFACES OF 60".
- 6. ALL METAL LONGITUDINAL SEAMS SHALL BE PITTSBURGH OR OTHER LISTED SMACNA LISTED SEAM. DO NOT USE BUTTON PUNCH SNAP-BACK SEAMS.
- 7. SUSPEND METAL DUCTWORK NOT EXCEEDING 30" LONGEST SIDE AT EVERY JOINT. DO NOT EXCEED 10'-0" HANGER SPACING. USE 1" X 18 GAGE GALVANIZED STRAPS (MINIMUM) ATTACHED TO BOTTOM AND SIDES OF DUCT.
- 8. SUSPEND METAL DUCTWORK EXCEEDING 30" LONGEST SIDE AT MAXIMUM 8'-0" SPACING USING ANGLES AND RODS.
- 9. SUPPORT DUCTWORK FROM STRUCTURAL MEMBERS. ATTACHMENT TO ROOF DECK IS NOT ACCEPTABLE.
- 10. DUCT SIZES SHALL BE VERIFIED FOR CLEARANCES AT THE JOB SITE PRIOR TO FABRICATION. DIMENSIONS MAY BE CHANGED TO ACCOMMODATE CONSTRUCTION CLEARANCES. FREE AREA OF DUCT SHALL BE MAINTAINED
- 11. DUCT TRANSITIONS SHALL BE CONSTRUCTED WITH SLOPE OF 1/4.
- PROVIDE ELBOWS AND CHANGES IN DIRECTION WITH SINGLE VANE TURNING VANES.
- 13. ALL JOINTS SHALL BE MADE AIRTIGHT BY APPROVED METHODS, INCLUDING TAPES, MASTICS, GASKETS OR OTHER APPROVED CLOSURE SYSTEMS. 14. TAPE ALONE CANNOT BE SUBSTITUTED FOR MECHANICAL FASTENERS.
- 15. TAPES AND MASTICS USED TO SEAL DUCTWORK MUST BE LISTED AND LABELED IN ACCORDANCE WITH UL 181A AND SHALL BE MARKED "181A-P" FOR PRESSURE-SENSITIVE TAPE, "181A-M" FOR MASTIC OR "181A-H" FOR HEAT SENSITIVE TAPE.
- 16. TAPES AND MASTICS USED TO SEAL FLEXIBLE AIR DUCTS SHALL COMPLY WITH UL 181B AND SHALL BE MARKED "181B-FX" FOR PRESSURE SENSITIVE TAPE, OR "181B-M" FOR MASTIC.
- 17. MECHANICAL FASTENERS USED WITH FLEXIBLE NON-METALLIC AIR DUCTS SHALL COMPLY WITH UL 181 AND SHALL BE MARKED "181B-".
- 18. FLEXIBLE CONNECTORS SHALL NOT BE USED.
- 19. HIGH EFFICIENCY TAKE-OFF FITTINGS WITH MANUAL DAMPER SHALL HAVE 2" STAND OFF BRACKET.
- 20. ALL BRANCH TAKE-OFFS TO INDIVIDUAL AIR INLET OR AIR OUTLET SHALL BE PROVIDED WITH MANUAL DAMPER. 21. ALL DUCTWORK SHALL BE A MINIMUM 26 GAUGE GALVANIZED SHEET

METAL

TEST AND BALANCE NOTES

THE MINIMUM REQUIREMENT FOR TESTING, ADJUSTING, AND BALANCING (TAB) OF THE HEATING, VENTILATION, AND AIR CONDITIONING (HVAC) DISTRIBUTION SYSTEMS SHALL BE AS FOLLOWS.

- CONTRACTOR SHALL BE RESPONSIBLE TO PROVIDE TESTING ADJUSTING AND BALANCING FOR THIS PROJECT
- THE MECHANICAL SYSTEMS SHALL BE TESTED, ADJUSTED AND BALANCED, INCLUDING SUPPLY AIR SYSTEM, RETURN AIR SYSTEM, EXHAUST AIR SYSTEM, OUTSIDE AIR SYSTEM AND ALL ASSOCIATED EQUIPMENT.
- CONTRACTOR PERFORMING TESTING ADJUSTING AND BALANCING WORK SHALL BE EITHER AABC OR NEBB CERTIFIED.
- TESTING ADJUSTING AND BALANCING SHALL BE PERFORMED IN ACCORDANCE WITH THE NEBB OR AABC TEST PROCEDURES.
- TESTING ADJUSTING AND BALANCING REPORT FORMS SHALL BE STANDARD FORMS FROM EITHER AABC OR NEBB.
- CONTRACTOR SHALL VERIFY QUANTITIES AND LOCATIONS OF ALL BALANCING DEVICES. CONTRACTOR SHALL VERIFY THAT THESE BALANCING DEVICES ARE ACCESSIBLE AND APPROPRIATE FOR BALANCING AND FOR EFFICIENT SYSTEM AND EQUIPMENT OPERATION PRIOR TO COMMENCING WORK.
- MECHANICAL AIR AND WATER SYSTEMS SHALL BE ADJUSTED TO WITHIN THE FOLLOWING TOLERANCES.
- PLUS 5 TO PLUS 10 PERCENT PLUS 5 TO PLUS 10 PERCENT
- EXHAUST FANS: PLUS 5 TO PLUS 10 PERCENT EQUIPMENT WITH FANS: PLUS 5 TO PLUS 10 PERCENT AIR OUTLETS AND INLETS: ZERO TO MINUS 10 PERCENT DOM. HW FLOW RATES: ZERO TO MINUS 10 PERCENT
- FINAL BALANCE REPORT SHALL INCLUDE THE FOLLOWING. TEST CONDITIONS FOR FANS
- SYSTEM DIAGRAMS AIR CONDITIONING UNIT TEST REPORTS FAN TEST REPORTS AIR TERMINAL DEVICE REPORTS

PENETRATION FIRESTOPPING NOTES

- 1. FIRE RATED PENETRATIONS DETAILS SHOWN ON THE CONSTRUCTIONS DOCUMENTS SHOW GENERAL METHOD OF MECHANICAL (HVAC) AND PLUMBING PENETRATION FIRESTOPPING.
- 2. CONTRACTOR SHALL REVIEW CONSTRUCTION DOCUMENTS AND PROVIDE SPECIFIC FIRESTOPPING DETAILS FROM A SPECIFIC FIRESTOPPING MANUFACTURER FOR EACH MECHANICAL (HVAC) AND PLUMBING PIPE OR DUCT PENETRATION FOR EACH FIRE RATED ASSEMBLY.
- 3. PROVIDE PENETRATION FIRESTOPPING THAT IS PRODUCED AND INSTALLED TO RESIST SPREAD OF FIRE ACCORDING TO REQUIREMENTS INDICATED, RESIST PASSAGE OF SMOKE AND OTHER GASES, AND MAINTAIN ORIGINAL FIRE-RESISTANCE RATING OF CONSTRUCTION PENETRATED.
- 4. PENETRATION FIRESTOPPING SYSTEMS SHALL BE COMPATIBLE WITH ONE ANOTHER, WITH THE SUBSTRATES FORMING OPENINGS, AND WITH PENETRATING ITEMS IF ANY.
- 5. PENETRATIONS IN FIRE-RESISTANCE-RATED WALLS: PROVIDE PENETRATION FIRESTOPPING WITH RATINGS DETERMINED PER ASTM E 814 OR UL 1479, BASED ON TESTING AT A POSITIVE PRESSURE DIFFERENTIAL OF 0.01-INCH WG
- 6. PENETRATION FIRESTOPPING PRODUCTS SHALL BEAR UL, ETL OR FM GLOBAL CLASSIFICATION MARKING OF QUALIFIED TESTING AND INSPECTING AGENCY.
- 7. DO NOT INSTALL PENETRATION FIRESTOPPING WHEN AMBIENT OR SUBSTRATE TEMPERATURES ARE OUTSIDE LIMITS PERMITTED BY PENETRATION FIRESTOPPING MANUFACTURERS OR WHEN SUBSTRATES ARE WET BECAUSE OF RAIN, FROST, CONDENSATION, OR OTHER CAUSES.
- 8. COORDINATE CONSTRUCTION OF OPENINGS AND PENETRATING ITEMS TO ENSURE THAT PENETRATION FIRESTOPPING IS INSTALLED ACCORDING TO SPECIFIED REQUIREMENTS.
- 9. COORDINATE SIZING OF SLEEVES, OPENINGS, CORE-DRILLED HOLES, OR CUT OPENINGS TO ACCOMMODATE PENETRATION FIRESTOPPING.
- 10. INSTALL PENETRATION FIRESTOPPING TO COMPLY WITH MANUFACTURER'S WRITTEN INSTALLATION INSTRUCTIONS AND PUBLISHED DRAWINGS FOR PRODUCTS AND APPLICATIONS INDICATED.
- 11. INSTALL FORMING MATERIALS AND OTHER ACCESSORIES OF TYPES REQUIRED TO SUPPORT FILL MATERIALS DURING THEIR APPLICATION AND IN THE POSITION NEEDED TO PRODUCE CROSS-SECTIONAL SHAPES AND DEPTHS REQUIRED TO ACHIEVE FIRE RATINGS INDICATED.
- 12. IDENTIFY PENETRATION FIRESTOPPING WITH PREPRINTED METAL OR PLASTIC LABELS. ATTACH LABELS PERMANENTLY TO SURFACES ADJACENT TO AND WITHIN 6 INCHES OF FIRESTOPPING EDGE SO LABELS WILL BE VISIBLE TO ANYONE SEEKING TO REMOVE PENETRATING ITEMS OR FIRESTOPPING

SMOKE DETECTOR NOTES

- 1. SMOKE DETECTORS SHALL BE PHOTOELECTRIC TYPE AND SHALL BE "SYSTEM SENSOR" DH100ACDCLP
- 2. SMOKE DETECTORS SHALL BE INSTALLED IN THE RETURN AIR DUCT OF ALL AIR HANDLING UNITS WITH CAPACITY GREATER THAN 2,000 CFM.
- PROVIDE SMOKE DETECTORS WHERE MULTIPLE AIR-HANDLING SYSTEMS SHARE COMMON SUPPLY OR RETURN AIR DUCTS OR PLENUMS WITH A COMBINED DESIGN CAPACITY GREATER THAN 2 000 CEM
- 4. THE SMOKE DETECTORS SHALL BE INSTALLED TO MONITOR THE ENTIRE AIRFLOW CONVEYED BY THE SYSTEM INCLUDING RETURN AIR AND EXHAUST OR RELIEF AIR.
- 5. PROVIDE ACCESS TO ALL SMOKE DETECTORS FOR INSPECTION AND MAINTENANCE 6. SMOKE DETECTOR SHALL BE INTERLOCKED WITH SUPPLY FAN.
- ELECTRICAL STARTER TO SHUT DOWN SUPPLY AIR FAN(S) ON SENSING SMOKE.
- 7. SMOKE DETECTOR SHALL BE INTERLOCKED WITH FIRE ALARM SYSTEM. 8. THE ACTUATION OF A DUCT SMOKE DETECTOR SHALL ACTIVATE A VISIBLE AND AUDIBLE SUPERVISORY SIGNAL AT A CONSTANTLY ATTENDED LOCATION.
- 9. IN ADDITIONAL TO INTERLOCKING THE SMOKE DETECTOR TO THE FIRE ALARM SYSTEM, THE SMOKE DETECTOR SHALL BE CONNECTED TO A MULTI-SIGNALLING ANNUNCIATOR PANEL (SYSTEM SENSOR SSK 451) FOR TESTING PURPOSES.
- 10. MULTI-SIGNALLING ANNUNCIATOR PANEL (SYSTEM SENSOR SSK 451) SHALL BE INSTALLED AS SHOWN ON DRAWING AND AS REQUIRED BY BUILDING OFFICIAL FOR TESTING.

MECHANICAL SPECIFICATIONS

- 230100 BASIC MECHANICAL REQUIREMENTS COORDINATE THE LOCATION OF ALL NEW ROOF OPENINGS AND THE LOCATION OF ALL NEW AND
- RELOCATED ROOF MOUNTED EQUIPMENT WITH THE EXISTING STRUCTURE AND ARCHITECTURAL PLANS PRIOR TO ANY INSTALLATION.
- V-BELT DRIVES SHALL BE OF FABRIC AND RUBBER CONSTRUCTION. BELT GUARDS SHALL BE PROVIDED FOR ALL EXPOSED BELTS AND DRIVES.
- PROVIDE 6" CONCRETE HOUSEKEEPING PADS UNDER ALL FLOOR MOUNTED EQUIPMENT. PROPERLY LUBRICATE ALL PIECES OF EQUIPMENT BEFORE TURNING THE SYSTEM OVER TO THE
- INSTALL DUCT MOUNTED SUPPLY AND RETURN AIR SMOKE DETECTORS IN ALL ROOFTOP, FAN-COIL. AIR-HANDLING, AND OTHER SUPPLY AIR SYSTEMS, WITH A CAPACITY GREATER THAN 2000 CFM. SMOKE DETECTORS ARE PURCHASED AND WIRED BY THE ELECTRICAL CONTRACTOR.

230500 - BASIC PIPING MATERIALS & METHODS

- CORE CUT ALL PIPE PENETRATION OF EXISTING MASONRY OR CONCRETE WALLS AND FLOORS. SLEEVE ALL PENETRATIONS THROUGH NEW WALLS AND FLOORS. SEAL ALL PENETRATIONS WATER TIGHT WITH SILICONE SEALANT, USE FIRE RATED SEALANT (3M "FIRE BARRIER" OR EQUAL) FOR 1 HOUR OR 2 HOUR PENETRATIONS
- CAULK AROUND ALL PIPING THAT PASSES THROUGH FIRE-RATED PARTITIONS WITH A NON-HARDENING CAULKING SIMILAR TO 3M "FIRE BARRIER".
- SEAL ALL PIPING THROUGH WALLS AIR TIGHT

230523 - VALVES

- PROVIDE VALVES OF THE TYPE AND QUANTITY SHOWN ON THE DRAWINGS. VALVES OF THE SAME TYPE TO BE BY ONE MANUFACTURER.
- 230548 VIBRATION ISOLATION AND SEISMIC BRACING
- ALL MECHANICAL EQUIPMENT DUCTWORK AND PIPING MUST BE VIBRATION ISOLATED AND SEISMICALLY BRACED FOR THE SITE SPECIFIC SEISMIC DESIGN CATEGORY AND SEISMIC USE GROUP, IN ACCORDANCE WITH THE LATEST ADOPTED EDITIONS OF THE IBC, UBC, ASHRAE, AND
- SMACNA, PROVIDE SEISMIC PRODUCTS BY AMBER-BOOTH OR MASON INDUSTRIES IN GENERAL PROVIDE SPRING MOUNTS TO ATTENUATE LOW FREQUENCY SOUND AND VIBRATION
- AND NEOPRENE PADS TO ATTENUATE HIGH FREQUENCY SOUND AND VIBRATION. SEISMIC BRACING/MOUNTING CAN BE COMBINED WITH VIBRATION ISOLATION AS APPLICABLE.
- CONTRACTOR MANUFACTURED SEISMIC BRACING/RESTRAINT METHODS ARE NOT ACCEPTABLE. PROVIDE A SIGNED AND STAMPED LETTER FROM A PROFESSIONAL ENGINEER CERTIFYING THAT THE SUPPLIED PRODUCTS ARE CORRECT FOR THE APPLICATION AND THAT THE INSTALLATION IS IN COMPLIANCE WITH ALL APPLICABLE CODES.

230553 - MECHANICAL IDENT PLASTIC TAPE: PROVIDE MANUFACTURER'S STAN PRESSURE-SENSITIVE (SELF ADHESIVE) VINYL T WIDE TAPE MARKERS ON PIPES WITH OUTSIDE D INSULATION, IF ANY); 2-1/2" WIDE TAPE FOR LARG DUCT MARKER PROVIDE MANUFACTURER'S STANDARD LAMINAT MARKERS. . COLOR: COMPLY WITH ANSI A13.1 LETTERING: MANUFACTURER'S STANDARD PRE-PRINTED NOM PIPING OR DUCT SYSTEM IN EACH INSTANCE OR IN CASES OF VARIANCE WITH NAMES AS SHOWN. ARROWS PRINT EACH MARKER WITH ARROWS INDICATING VALVE TAGS: PROVIDE PLASTIC LAMINATE VALVE TAGS' MANU ENGRAVED TAGS WITH PIPING SYSTEM ABBREVI SEQUENCED VALVE NUMBERS 1/2" HIGH, WITH 5/3 SQUARE BLACK TAGS WITH WHITE LETTERING VALVE TAG FASTENERS: PROVIDE MANUFACTURER'S STANDARD SOLID BR OR SOLID BRASS S-HOOKS OF THE SIZED REQUI VALVES, AND MANUFACTURED SPECIFICALLY FO 230593 - TESTING, ADJUSTIN OBTAIN THE SERVICES OF AN INDEPENDENT TEST AND ADJUST THE SYSTEM. THIS SHALL BE DONE I OF THIS TYPE. BALANCING SHALL BE DONE IN AC ALL DATA SHALL BE RECORDED AND A REPORT SI CLOSE OUT 230700 - MECHANICAL INSULA PIPE INSULATION TO BE SNAP-ON GLASS FIBER AND JOINTS TO PROVIDE A COMPLETELY SEAL UNICELLULAR ASTM 534 TYPE 1 INSULATION. US 1/2" FOR PIPE OVER 2"Ø WRAP ALL SUPPLY AND RETURN DUCTWORK WI INSULATION. WRAP INSULATION TIGHTLY ON TH BUTTED AND LONGITUDINAL JOINTS OVERLAPP FOIL-REINFORCED 'KRAFT' TAPE, 3" WIDE, DUC" WITH A MINIMUM R-5 WHILE EXTERIOR DUCTWO 3 NO RETURN AIR DUCT INSULATION IS REQUIRE TEMPERATURE DIFFERENCE IS LESS THAN 10°F OUTDOOR DUCTWORK EXPOSED TO THE WEATH BE FITTED WITH 0.016 EMBOSSED ALUMINUM JAC WEATHERPROOF FIT 233113 - METAL DUCTWORK ALL DUCTWORK SHALL BE CONSTRUCTED, E THE MOST RESTRICTIVE OF LOCAL REGULAT ASHRAE HANDBOOK OF FUNDAMENTALS, OR THE SHEET METAL AND AIR CONDITIONING C (SMACNA). TRANSITION ALL NEW DUCTWORK TO CONNE DUCTWORK SHALL BE GALVANIZED STEEL TH THAT NO VIBRATION OR NOISE RESULTS. IT GALVANIZED MILLED STEEL SHEETS OF U.S. BLISTERS, SLIVERS, AND PITS. ALL SEAMS S DUCTWORK, INCLUDING GAUGES OF METAL ACCORDANCE WITH SMACNA. SLEEVES FOR AN EXTENSION OF THE FIRE WALL SHALL BE SEAL DUCTWORK ACCORDING TO THE FOLLO DUCT LOCATION UNCONDITIONED SPACES ONDITIONED SPACES C (CONCEALED DUCTWORK) CONDITIONED SPACES (EXPOSED DUCTWORK) HANGERS FOR DUCTS UP TO 18" IN WIDTH OR THAN 8 FOOT CENTERS. DUCTS 19" AND OVE SUPPORTED ON NOT MORE THAN 4 FOOT CE CONSTRUCTED OF GALVANIZED BAND IRON DIAMETER. HANGERS SHALL EXTEND DOWN RECTANGULAR DUCTS, AND WRAP COMPLET SHALL BE RIGIDLY SUPPORTED. ALL DUCTWORK SHALL BE CLEANED PRIOR T DIFFUSERS. OPERATE FANS TO BLOW OUT D RECTANGULAR LOW-PRESSURE SUPPLY AND WITH 1" FACED FIBERGLASS INSULATION SEC **INSULATION SHALL BE 1-1/2 POUND DENSITY** OUTDOOR DUCTWORK EXPOSED TO THE WEA FACED FIBERGLASS INSULATION SECURELY I

MECHANICAL SI

- SHALL BE FITTED WITH A 0.016 EMBOSSED ALL WEATHERPROOF FIT. DUCT DIMENSIONS SHOWN ON DRAWINGS ARI INCREASED TO ACCOMMODATE INSULATION. JOHN-MANSVILLE OR SCHULLER INTERNATIO
- CLASS I KITCHEN EXHAUST HOOD DUCT SYST A TYPE I COMMERCIAL HOOD AND GREASE
- FROM COMBUSTIBLE AND NONCOMBUSTI IMC SECTION 507.9 AND ASTM E23-36. B. CONSTRUCT EXHAUST DUCT OF WELDED
- CONCEALED DUCTS, AND WELDED OR FLA EXPOSED DUCTS C. SLOPE HORIZONTAL DUCT AT 1/4" PER FOOT
- . PROVIDE ACCESS DOORS AT EACH CHANG . PROVIDE RESIDUE TRAP AT THE BASE OF
- CI FANOLIT F. ALL SEAMS, JOINTS AND PENETRATIONS S EXTERNAL WELD.
- G. PROVIDE AND INSTALL ONE OF THE FOLLO FIRE RESISTIVE CONSTRUCTION OR, A DU DUCT FIRE PROTECTION SYSTEM, OR APPI DUCT SYSTEM - METAL FAB MODEL "NO CH WHICHEVER METHOD IS CHOSEN MUS

IECHANICAL SPECIFICATIONS	MECHANICAL SPECIFICATIONS	Jh Jane 047 Som
- MECHANICAL IDENTIFICATION	233300 - DUCTWORK ACCESSORIES	
KERS: APE: PROVIDE MANUFACTURER'S STANDARD COLOR-CODED E-SENSITIVE (SELF ADHESIVE) VINYL TAPE, NOT LESS THAN 3 MILS THICK. 1-1/2" E MARKERS ON PIPES WITH OUTSIDE DIAMETERS LESS THAN 6" (INCLUDING DN, IF ANY); 2-1/2" WIDE TAPE FOR LARGER PIPES.	 FLEXIBLE DUCTWORK: THE FINAL 5 FOOT CONNECTION TO GRILLES AND DIFFUSERS IN LAY-IN CEILINGS, OR TO FLOOR MOUNTED GRILLES, MAY BE MADE WITH FLEXIBLE DUCT, FLEXMASTER TYPE 5M ONLY. ENDS SHALL BE SEALED. SQUARE/RECTANGULAR ELBOWS SHALL BE PROVIDED WITH TURNING VANES. 	lit L. L.
RKERS: MANUFACTURER'S STANDARD LAMINATED PLASTIC; COLOR CODED DUCT	3. PROVIDE FLEXIBLE CONNECTIONS NOT LESS THAN 4" WIDE CONSTRUCTED OF HEAVY, WATERPROOF, WOVEN PLASTIC COATED GLASS FABRIC AT SUPPLY AND RETURN CONNECTIONS TO HEAT PUMPS, AIR HANDLING, ROOFTOP, MAKE-UP AIR OR FAN-COIL UNITS. CORNERS SHALL BE SEWN TIGHT. CONNECTIONS SHALL BE 20 OUNCE VENTFABRICS OR	Donald Donald Bandy and Sandy as Soli 54
VITH ANSI A13.1 G: TURER'S STANDARD PRE-PRINTED NOMENCLATURE WHICH BEST DESCRIBES DUCT SYSTEM IN EACH INSTANCE OR AS SELECTED BY ARCHITECT OR ENGINEER OF VARIANCE WITH NAMES AS SHOWN. CH MARKER WITH ARROWS INDICATING DIRECTION OF FLOW.	 EQUAL. COMBINATION FIRE AND SMOKE DAMPERS, SMOKE DAMPERS, OR FIRE DAMPERS IN DUCTWORK THROUGH ALL FLOORS AND FIRE WALLS SHALL BE FURNISHED AND INSTALLED AS REQUIRED TO CONFORM TO THE LATEST NFPA BULLETIN CONCERNING THIS TYPE OF BUILDING AND SHALL BE LISTED AND LABELED IN ACCORDANCE WITH THE STANDARDS AND REQUIREMENTS OF UL555 AND UL555S. DAMPERS, COMPLETE WITH MOUNTING ANGLES, SHALL BE MULTI-BLADE, FUSIBLE LINK, SPRING ACTING WITH 11 GAUGE SLEEVE. FUSIBLE LINK SHALL BE RATED AT 165°F. CONTROLLED BY AUTOMATIC SMOKE DETECTION IN DUCT OR AREA OF SMOKE DISPERSION. 	75, dv
GS: PLASTIC LAMINATE VALVE TAGS: MANUFACTURER'S STANDARD 3/32" THICK D TAGS WITH PIPING SYSTEM ABBREVIATION IN 1/4" HIGH LETTERS AND ED VALVE NUMBERS 1/2" HIGH, WITH 5/32" HOLE FOR FASTENER. PROVIDE 1-1/2" LACK TAGS WITH WHITE LETTERING.	 DUCT MOUNTED BALANCING DAMPERS SHALL BE USED TO CONTROL SUPPLY AIR TO EACH DIFFUSER AND GRILLE. AN OPERATING HEAD SHALL BE PLACED ON THE SIDE OF THE DUCT WITH A POSITIVE LOCKING QUADRANT. DAMPERS SHALL BE PROVIDED IN RETURN AND EXHAUST AIR DUCTS WHERE SHOWN ON DRAWINGS. COORDINATE THE LOCATION OF CEILING ACCESS PANELS. 	
G FASTENERS: MANUFACTURER'S STANDARD SOLID BRASS CHAIN (WIRE LINK OR BEADED TYPE), BRASS S-HOOKS OF THE SIZED REQUIRED FOR PROPER ATTACHMENT OF TAGS TO ND MANUFACTURED SPECIFICALLY FOR THAT PURPOSE.	 PROVIDE CEILING ACCESS DOORS AT ALL LOCATIONS OF BALANCING DAMPERS, FIRE DAMPERS, FIRE/SMOKE DAMPERS, VALVES, ETC., WHERE THERE IS NOT A LIFT-OUT TYPE CEILING. ACCESS DOORS SHALL BE HINGED OF METAL CONSTRUCTION WITH SCREWDRIVER LATCHES. ACCESS DOORS TO BE LISTED AND FIRE RATED EQUAL TO OR GREATER THAN THE RATING ASSEMBLY THEY ARE INSTALLED IN. 	
- TESTING, ADJUSTING, AND BALANCING	7. AT FIRE DAMPERS, A DUCT MOUNTED SHEET METAL HINGED DOOR SHALL BE PROVIDED AND INSTALLED WITH POSITIVE LOCKING HANDLE. WHERE DUCTS ARE INSULATED, COVERS	
E SERVICES OF AN INDEPENDENT TESTING AND BALANCING AGENCY TO BALANCE IT THE SYSTEM. THIS SHALL BE DONE BY PERSONS FULLY FAMILIAR WITH SYSTEMS PE. BALANCING SHALL BE DONE IN ACCORDANCE TO AABC OR NEBB STANDARDS. SHALL BE RECORDED AND A REPORT SUBMITTED TO THE ENGINEER PRIOR TO JOB	SHALL BE INSULATED. FIRE DAMPERS SHALL BE LISTED AND LABELED IN ACCORDANCE WITH THE STANDARDS AND REQUIREMENTS OF UL555. CONTROLLED BY FIRE DETECTOR, FUSABLE LINK, OR ELECTRICAL FUSABLE LINK. PROVIDE 1, 1-1/2, OR 3 HR FIRE RATED MATERIALS AT ALL PENETRATIONS OF FIRE BARRIERS BY DUCTS. SYSTEM APPROVED BY ASTM E 814 OR EQUAL.	THE DESIGNS SHOWN AND DESCRIBED HEI NCLUDING ALL TECHNICAL DRAWINGS, GRAPHIC REPRESENTATION & MODELS
- MECHANICAL INSULATION	 GRAVITY OR BACKDRAFT DAMPERS SHALL BE ALL ALUMINUM CONSTRUCTION, INTERCON- NECTED AND BLADED, PRESSURE DROP THROUGH DAMPERS SHALL NOT EXCEED 0.04" W.G. FIRE ALARM CONTRACTOR SHALL TEST FOR FIRE/SMOKE DAMPERS AS REQUIRED BY LOCAL BUILDING OFFICIAL AND FIRE AUTHORITY PRIOR TO OCCUPANCY. 	THEREOF, ARE PROPRIETARY & CAN NOT COPIED, DUPLICATED, OR COMMERCIALLY EXPLOITED IN WHOLE OR IN PART WITHOU THE SOLE AND EXPRESS WRITTEN
JLATION TO BE SNAP-ON GLASS FIBER TYPE WITH VAPOR JACKET. SEAL ALL ENDS VTS TO PROVIDE A COMPLETELY SEALED SYSTEM. ALTERNATIVELY, USE FLEXIBLE JLAR ASTM 534 TYPE 1 INSULATION. USE 1" THICKNESS FOR PIPE UP TO 2"Ø, AND 1 PIPE OVER 2"Ø	233416 - FANS	PERMISSION FROM DONALD L. WELCH ARCHITECT THESE DRAWINGS ARE AVAILABLE FOR
LI SUPPLY AND RETURN DUCTWORK WITH 1-1/2" THICK FOIL FACED FIBERGLASS ION. WRAP INSULATION TIGHTLY ON THE DUCT WITH ALL CIRCUMFERENTIAL JOINTS AND LONGITUDINAL JOINTS OVERLAPPED A MIN. OF 2". COVER ALL JOINTS WITH NFORCED 'KRAFT' TAPE, 3" WIDE. DUCTWORK INTERIOR TO BUILDING ENVELOPE MINIMUM R-5 WHILE EXTERIOR DUCTWORK INSULATION SHALL BE MINIMUM R-12. IRN AIR DUCT INSULATION IS REQUIRED IF THE RETURN AIR AND PLENUM ATURE DIFFERENCE IS LESS THAN 10°F	 ROOF MOUNTED EXHAUST FANS SHALL BE COMPLETE WITH BACKDRAFT DAMPERS. A DISCONNECT SWITCH SHALL BE PROVIDED AT THE FAN. THE DISCONNECT SWITCH SHALL TURN OFF THE FAN WITH THE ACTIVATION OF SMOKE DETECTION. THE FAN SHALL BE COMPLETE WITH INSECT SCREEN AND PREFABRICATED ROOF 	LIMITED REVIEW AND EVALUATION BY CLIE CONSULTANTS, CONTRACTORS, GOVERNME AGENCIES, VENDORS, AND OFFICE PERSON DNLY IN ACCORDANCE WITH THIS NOTICE.
R DUCTWORK EXPOSED TO THE WEATHER SHALL HAVE 2" INSULATION AND SHALL D WITH 0.016 EMBOSSED ALUMINUM JACKET POP-RIVITED FOR A TIGHT RPROOF FIT.	 CURB MATCHING THE FAN SIZE. CEILING MOUNTED EXHAUST FANS SHALL BE COMPLETE WITH LOUVERED GRILLE, BACKDRAFT DAMPER, AND WALL CAP OR ROOF CAP, SEE PLANS. FANS FOR GREASE HOOD APPLICATIONS SHALL BE UPBLAST TYPE, LISTED AND LABELED FOR GREASE HOOD USE AND INSTALLED PER APPLICABLE CODES. 	consultant:
JCTWORK SHALL BE CONSTRUCTED, ERECTED, AND TESTED IN ACCORDANCE WITH OST RESTRICTIVE OF LOCAL REGULATIONS AND PROCEDURES DETAILED IN THE AE HANDBOOK OF FUNDAMENTALS, OR THE APPLICABLE STANDARDS ADOPTED BY HEET METAL AND AIR CONDITIONING CONTRACTOR'S NATIONAL ASSOCIATION, NA). SITION ALL NEW DUCTWORK TO CONNECT TO EXISTING, AS REQUIRED.	 UTILITY FAN SETS SHALL BE BELT DRIVEN, CENTRIFUGAL FANS CONSISTING OF WEATHER PROOF HOUSING, WHEEL FAN SHAFT, BEARINGS, MOTOR, DISCONNECT SWITCH, DRIVE ASSEMBLY, DRAIN CONNECTION AND ACCESSORIES. MANUFACTURERS: COOK, ILG, PENN, GREENHECK, & BROAN 	03-21-2017 4 No. 9520491 5 BENJAMIN J. 5 CHLUP
WORK SHALL BE GALVANIZED STEEL THROUGHOUT, FABRICATED AND INSTALLED SO NO VIBRATION OR NOISE RESULTS. IT SHALL BE MADE FROM THE BEST GRADE OF INIZED MILLED STEEL SHEETS OF U.S. STANDARD GAUGE AND BE FREE FROM	233713 - GRILLES, DIFFUSER AND LOUVERS	PATE OF TAN
ERS, SLIVERS, AND PITS. ALL SEAMS SHALL BE AIRTIGHT, THE CONSTRUCTION OF ALL NORK, INCLUDING GAUGES OF METAL, BRACING LAYOUT, ETC., SHALL BE IN RDANCE WITH SMACNA. SLEEVES FOR FIRE DAMPERS AND DUCT SECTIONS FORMING TENSION OF THE FIRE WALL SHALL BE 10 GAUGE STEEL.	 ALL GRILLES, DIFFUSERS, AND REGISTERS SHALL BE COMPLETE WITH FRAMES AND RUBBER GASKETS. FINISH FOR ALL REGISTERS, DIFFUSERS, AND GRILLES SHALL BE WHITE. 	
DUCTWORK ACCORDING TO THE FOLLOWING SMACNA DUCT SEALING CLASS:	2. COORDINATE THE LOCATIONS OF ALL CEILING DIFFUSERS, REGISTERS, AND GRILLES WITH THE ARCHITECTURAL REFLECTED CEILING PLAN, ELECTRICAL LIGHTING	project:
DUCT LOCATION DUCT TYPE SUPPLY EXHAUST <2in. Wg.	 LAYOUT, AND ARCHITECTURAL ELEVATIONS. LOUVERS SHALL HAVE MINIMUM FREE AREA AND MAXIMUM PRESSURE DROP AS LISTED IN THE SCHEDULES. LOUVER SHALL HAVE FRAME AND SILLS COMPATIBLE WITH ADJACENT SUBSTRATE AND FIT ACCURATELY FOR WEATHERPROOF INSTALLATION. LOUVERS SHALL BE COMPLETE WITH 1/2" MESH ANODIZED ALUMINUM DIDD SOFECH. 	Tenant Finish for New
(CONCEALED DUCTWORK) CONDITIONED SPACES A A B B (EXPOSED DUCTWORK)	BIRD SCREEN.	Brighton
ERS FOR DUCTS UP TO 18" IN WIDTH OR DIAMETER SHALL BE PLACED ON NOT MORE 8 FOOT CENTERS. DUCTS 19" AND OVER IN WIDTH OR DIAMETER SHALL BE DRTED ON NOT MORE THAN 4 FOOT CENTERS. DUCT HANGERS SHALL BE TRUCTED OF GALVANIZED BAND IRON 1-1/8" FOR DUCTS UP TO 36" IN WIDTH OR TER. HANGERS SHALL EXTEND DOWN SIDES AND A MINIMUM OF 1" UNDER NGULAR DUCTS, AND WRAP COMPLETELY AROUND ROUND DUCTS. ALL DUCTS BE RIGIDLY SUPPORTED.		Recovery Campus 4905, 4911, 4915,
JCTWORK SHALL BE CLEANED PRIOR TO THE INSTALLATION OF CEILING AND SERS. OPERATE FANS TO BLOW OUT DUCTWORK. ANGULAR LOW-PRESSURE SUPPLY AND RETURN AIR DUCTWORK SHALL BE LINED "FACED FIBERGLASS INSULATION SECURELY BUTTONED OR LAPPED AND SEALED. ATION SHALL BE 1-1/2 POUND DENSITY.		4925, 4931, & 4953 South 900 East Salt Lake County
DOR DUCTWORK EXPOSED TO THE WEATHER SHALL BE LINED WITH MINIMUM R-8 D FIBERGLASS INSULATION SECURELY BUTTONED OR LAPPED AND SEALED, AND BE FITTED WITH A 0.016 EMBOSSED ALUMINUM JACKET POP RIVETED FOR A HERPROOF FIT.		Utah
DIMENSIONS SHOWN ON DRAWINGS ARE INSIDE CLEAR AREA AND SHALL BE ASED TO ACCOMMODATE INSULATION. DUCT LINER TO BE BY KNAUF GmbH, MANSVILLE OR SCHULLER INTERNATIONAL.		date February 24, 20
I KITCHEN EXHAUST HOOD DUCT SYSTEMS: PE I COMMERCIAL HOOD AND GREASE DUCT SHALL MEET CLEARANCE REQUIREMENTS DM COMBUSTIBLE AND NONCOMBUSTIBLE CONSTRUCTION IN ACCORDANCE TO 2012 SECTION 507.9 AND ASTM E23-36. NSTRUCT EXHAUST DUCT OF WELDED 16 GAGE CARBON STEEL SHEETS FOR		revisions
NCEALED DUCTS, AND WELDED OR FLANGED 18 GAGE STAINLESS STEEL FOR POSED DUCTS. PRE HORIZONTAL DUCT AT 1/4" PER FOOT TOWARD HOOD. DVIDE ACCESS DOORS AT EACH CHANGE OF DIRECTION. DVIDE RESIDUE TRAP AT THE BASE OF EACH VERTICAL RISER, WITH PROVISIONS FOR EANOUT. . SEAMS, JOINTS AND PENETRATIONS SHALL HAVE A LIQUID-TIGHT, CONTINUOUS, TERNAL WELD.		PERMIT SET—December 28, 20 ADDENDUM #1—January 04, 20 ADDENDUM #3—January 11, 20 ADDENDUM #4—January 17, 20 ADDENDUM #5—January 20, 20
DVIDE AND INSTALL ONE OF THE FOLLOWING SYSTEMS: DUCT ENCLOSURE WITH 2-HR E RESISTIVE CONSTRUCTION OR, A DUCT WRAP SYSTEM - 3M FIREMASTER GREASE CT FIRE PROTECTION SYSTEM, OR APPROVED EQUAL, OR, A PREFABRICATED GREASE CT SYSTEM - METAL FAB MODEL "NO CHASE IPIC", OR APPROVED EQUAL. WHICHEVER METHOD IS CHOSEN MUST HAVE APPROVAL FROM THE ADMINISTRATIVE AUTHORITY AND STATE FIRE MARSHALL.		7 ADDENDUM#7—February 24, 20
		data project no:
		drawn by:
		checked by: title
		MECHANICAL EQUIPMENT

SPECIFICATIONS sheet



BUILDING 'B'

	ELECTRIC UNIT HEATER SCHEDULE										
	MANUFACTURER					ELE		AL.	OPERATING		ACCESSORIES
SYMBOL	AND MODEL NO.	LOCATION	ARRANGEMENT	CFM	KW MOTOR VOLT			WEIGHT	NOTES	AND REMARKS	
	AND MODEL NO.			ĸ		H.P.	VOLI	PHASE	(LBS.)		
EUH-1	TRANE UHEC03	WATER ENTRIES	VERTICAL	400	3.3	1/125	208	1	132	3	WALL HUNG
EUH-2	TRANE UHCA02	EXIT DOORS	HORIZONTAL	-	2.0	-	208	1	-	1,2	RECESSED, CEILING MOUNTED
EUH-3	TRANE UHAA15	CUSTODIAN	VERTICAL	-	1.5	-	208	1	22	1,2	RECESSED, WALL MOUNTED

NOTES:

(1) UNIT MOUNTED TAMPERPROOF THERMOSTAT (2) UNIT MOUNTED DISCONNECT SWITCH

(3) PROVIDE WALL MOUNTED LINE VOLTAGE THERMOSTAT AND TAMPERPROOF WALL BRACKET

DIFFUSER AND GRILLE SCHEDULE								
SYMBOL	MANUFACTURER AND MODEL NO.	LOCATION	CFM	OVERALL SIZE	NOTES	ACCESSORIES AND REMARKS		
SG-1	TITUS 300R	CEILING	SEE PLANS	14 X 6 10 X 6	3,5	CEILING SUPPLY GRILLE W/ FIRE DAMPER		
CD-1	TITUS PAS-FR	CEILING	SEE PLANS	24 X 24 12 X 12	2,5	CEILING DIFFUSER W/ FIRE DAMPER		
RG-1	TITUS PAR-FR	CEILING	SEE PLANS	24 X 24 16 X 16	2,5 7	RETURN GRILLE W/ FIRE DAMPER		
EG-1	TITUS 63F	EXTERIOR EXHAUST TERMINATION	SEE PLANS	8X6	4	EXHAUST DISCHARGE GRILLE, ALUMINUM		
DG-1	TITUS CT-700L	DOOR TRANSFER	SEE PLANS	18 X 12	1	DOOR GRILLE		

NOTES: (1) PROVIDE AUXILIARY FRAME FOR TO ALLOW FOR FINISHED LOOK ON BOTH SIDES OF DOOR.

(3) PROVE DOUBLE DEFLECTION GRILLE WITH INTEGRAL BALANCING DAMPER. (d) REOVIDE DECESSARY FRAME TO ALLOW FOR INSTALLATION ON BOTTOM SIDE OF EXISTING EXTERIOR OVERHANG. (5) PROVIDE UL CLASSIFIED <u>FIRE RATED</u> CEILING DIFFUSER ASSEMBLY.

	EXHAUST FAN SCHEDULE											
					FAN		ELECTR	ICAL		OPERATING		
SYMBOL	MANUFACTURER	LOCATION	TYPE			MO	TOR			WEIGHT	CONTROL	ACCESSORIES AND REMARKS
	AND MODEL NO.			CFM	ESP	H.P.	WATTS	VOLT	PHASE	(LBS.)	METHOD	
EF-1	PANASONIC FV-05-11VKS1	PRIVATE UNIT BATHROOMS	CEILING	110	0.5	-	57	115	1	27	1	CEILING MOUNTED W/ WHITE GRILLE

CONTROL METHOD: (1) CONTROLLED BY WALL SWITCH (2) FAN RUNS CONTINUOUSLY DURING BUILDING OCCUPANCY (3) CONTROLLED BY LINE VOLTAGE SPACE THERMOSTAT

(1) STANDARD DISCONNECT NEMA 1 (2) BACKDRAFT DAMPER (3) FLEX DUCT CONNECTION (4) FAN SPEED CONTROLLER 5A 120V PREWIRED (5) RUBBER ISOLATOR SET (4) (6) PROVIDE UL LISTED CEILING RADIATION DAMPER TO MATCH FAN TYPE (PANASONIC-RD05C3)

ROOFTOP UNIT SCHEDULE (2-STAGE HEATING/COOLING)

										•		
SYMBOL M	MANUFACTURER	MODEL #	CFM	ESP	VOLT/PH	EER	COOLING CAP HI STAGE	HEATING INPUT	ELECTRICAL			DIMEN
STNIDOL	MANOFACTORER	MODEE #		LOF	VOLI/FH		(BTUH)	(BTUH)	VOLT/PH	MCA (AMPS)	MAX FUSE	ΗΧ۷
RTU-1	TRANE	4YCZ6036	1200	1.0	208/3	16.0	36,000	96,000	208/3	19.1	30 A	48" X 4
RTU-2	TRANE	YHC047E3	1600	1.0	208/3	16.0	50,500	120,000	208/3	28.9	40 A	41" X 53
(4) 55(

(1) PROVIDE DIGITAL REMOTE PROGRAMMABLE THERMOSTAT IN LOCKABLE COVER. (2) 0-25% MANUAL FRESH AIR DAMPER (BUILDING B RTUS)

(3) 0-100% HORIZONTAL ECONOMIZER (BUILDINGS A & C THRU F RTUS)

(4) 13" HIGH ROOF CURB/PLATFORM

(5) CRANKCASE HEATER FOR LOW AMBIENT COOLING (6) PROVIDE INSULATED DUCT SHROUD ON ALL EXTERIOR DUCTWORK

(7) GAS PRESSURE REGULATOR & ISOLATION VALVE

(8) 120 V CONVENIENCE OUTLET INTEGRAL TO UNIT (9) CONDENSER COIL HAIL GUARD

(10) NON-FUSED DISCONNECT INTEGRAL TO UNIT

(11) GAS & ELECTRIC FEEDS TO ENTER THROUGH BASE OF UNIT

					D	UCTLE	SS SP	LIT SY	STEM
			INDOC	OR UNIT		COOLING	HEATING		
SYMBOL	MANUFACTURER	MODEL #	CFM	VOLT/PH	RLA (AMPS)	CAPACITY (BTUH)	CAPACITY (BTUH)	SYMBOL	VOLT/PH
DSS-1	LENNOX	MS8-HI-24P	590	208/1	0.24	25,000	26,000	CU-1	208/1
DSS-2	LENNOX	MS8-HI-30P	705	208/1	0.40	30,000	33,000	CU-2	208/1
 (2) BUI (3) MUI (4) DEF 	DVIDE REMOTE PRO LT IN CONDENSATE LTI-SPEED FAN FROST CONTROL WPRESSOR OVERCI	PUMP / DISCHAF	RGE CC				•	J.) BUILDIN	IG C COOLII

 (5) COMPRESSOR OVERCURRENT PROTECTION
 (6) PROVIDE MANUFACTURER'S WALL CHANNEL (SPEEDICHANNEL SYSTEM) TO CONCEAL ALL REFRIGERANT PIPING EXPOSED TO VIEW AND EXTERIOR CONDITIONS. (7) PROVIDE MANUFACTURER'S CONDENSER PAD 18 X 36 X 2

(2) PROVIDE FRAME AND BALANCING DAMPER ACCESSIBLE THROUGH GRILLE FOR HARDLID CEILING APPLICATIONS AS REQUIRED.

ACCESSORIES:


ENSIONS WEIGHT XWXL (LBS) (45" X 52" 550 800 (53" X 88"

COMMENTS


HORIZONTAL SUPPLY/RETURN HORIZONTAL SUPPLY/RETURN

ΞN	M HEAT PUMP								
	COMMENTS								
РΗ	MCA (AMPS)	MODEL #	HSPF	SEER	COMMENTS				
1 16.0 MS8-HO-24P 10.20 18.00					HIGH SIDEWALL STYLE (BLDGS. A, B, D, E & F)				
1	20.0 MS8-HO-30P 8.20 16.00 HIGH SIDEWALL STYLE (BLDG. C)								
JLI	LING SETPOINT 70F (ADJ.) MAINTAIN 50F HEATING SETPOINT (ADJ)								



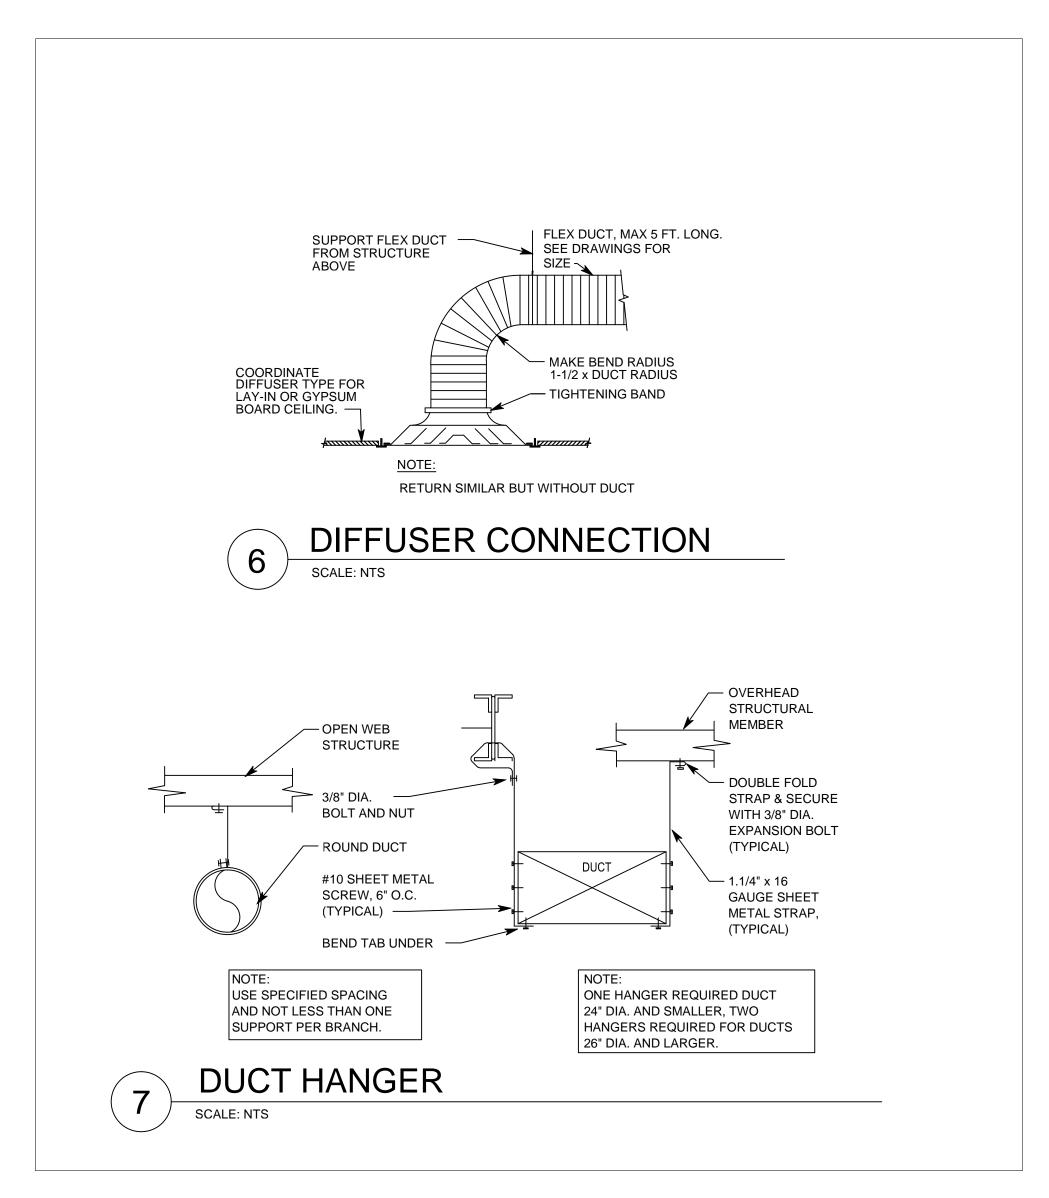

Lane 4047 Donald L. Welch Architect 7533 Sandy Land Lá Midvale, Utah 840 801.548-6391 dwelch5977®msn.ce THE DESIGNS SHOWN AND DESCRIBED HEREIN NCLUDING ALL TECHNICAL DRAWINGS, GRAPHIC REPRESENTATION & MODELS THEREOF, ARE PROPRIETARY & CAN NOT BE COPIED, DUPLICATED, OR COMMERCIALLY EXPLOITED IN WHOLE OR IN PART WITHOUT THE SOLE AND EXPRESS WRITTEN PERMISSION FROM DONALD L. WELCH ARCHITECT THESE DRAWINGS ARE AVAILABLE FOR LIMITED REVIEW AND EVALUATION BY CLIENTS CONSULTANTS, CONTRACTORS, GOVERNMENT AGENCIES, VENDORS, AND OFFICE PERSONNEL ONLY IN ACCORDANCE WITH THIS NOTICE. consultant: JFESS 03-21-2017 No. 9520491 BENJAMIN J SCHLUP/ project: Tenant Finish for New Brighton Recovery Campus 4905, 4911, 4915, 4925, 4931, & 4953 South 900 East Salt Lake County, Utah date February 24, 2017 revisions PERMIT SET-December 28, 2016 1 ADDENDUM #1-January 04, 2017 3 ADDENDUM #3-January 11, 2017 4 ADDENDUM #4-January 17, 2017 5 ADDENDUM #5-January 20, 2017 7 ADDENDUM#7-February 24, 2017 data project no: drawn by: checked by: title MECHANICAL DETAILS sheet M12 BUILDING 'B'

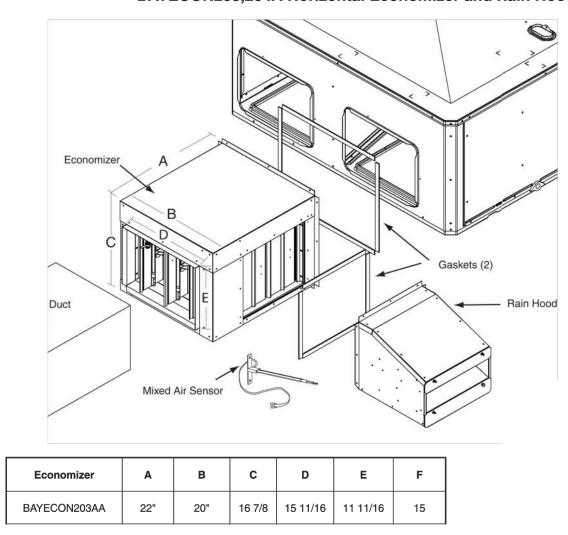

BAYECON203,204A Horizontal Economizer and Rain Hood

3 HORIZONTAL ECONOMIZER DETAIL (3 TON) SCALE: NTS

Stainless Steel Drain Pan

For excellent corrosion and oxidation resistance, the optional stainless steel drain pan provides a cleanable surface that complement other IAQ solutions such as high efficiency filtration (MERV 8 or 13), demand control ventilation (CO₂), and hot gas reheat.

Powered or Unpowered Convenience



This option is a GFCI, 120V/15amp, 2 plug, convenience outlet, either powered or unpowered. This option can only be ordered when Through the Base Electrical with either the Disconnect Switch or Circuit Breaker option is ordered. Note: Not available on 460V/575V units.

Through-the-Base Electrical Utility Access



both control and main power connections inside the curb and through the base of the unit. Option will allow for field installation of liquidtight conduit and an external field installed disconnect switch.



An electrical service entrance shall be Factory provided through the base openings simpl provided allowing electrical access for wiring and piping. Because these utility openings frequently minimize the number of roof penetration integrity of roofing materials is enhanced.



RECOMME	RECOMMENDED SERVICE CLEARANCE MM/IN.								
		WITH ECONOMIZER							
BACK SIDE	304.8 [12]	762.0 [30]							
LEFT SIDE	762.0 [30]	9 4.4 [36]							
RIGHT SIDE	914.4 [36]	-							
FRONT SIDE	1066.8 [42]	-							

BOTTOM

BACK SIDE


LEFT SIDE

RIGHT SIDE

FRONT SIDE

TOP


Optional Equipment

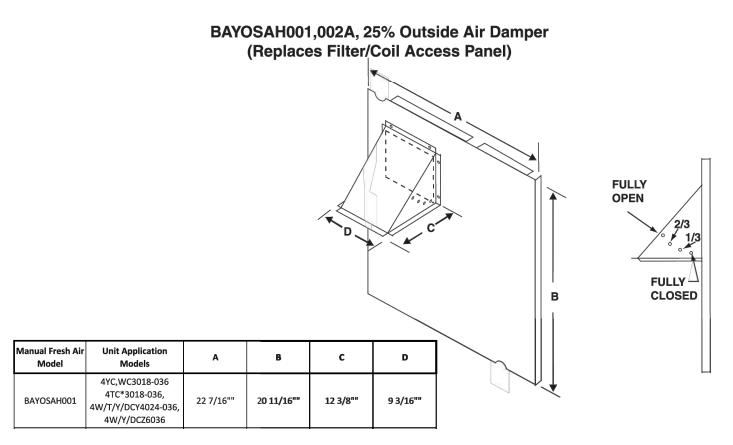

2)25% OUTSIDE AIR DAMPER (3 TON) SCALE: NTS


SCALE: NTS

Touchscreen Programmable Thermostat (2H/2C)

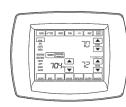

Two Heat/Two Cool programmable thermostat with touch screen digital display. Menu-driven programming. Effortless set-up. Program each day separately with no need to copy multiple days. All programming can be done on one screen. Easy to read and use. Large, clear backlit digital display.



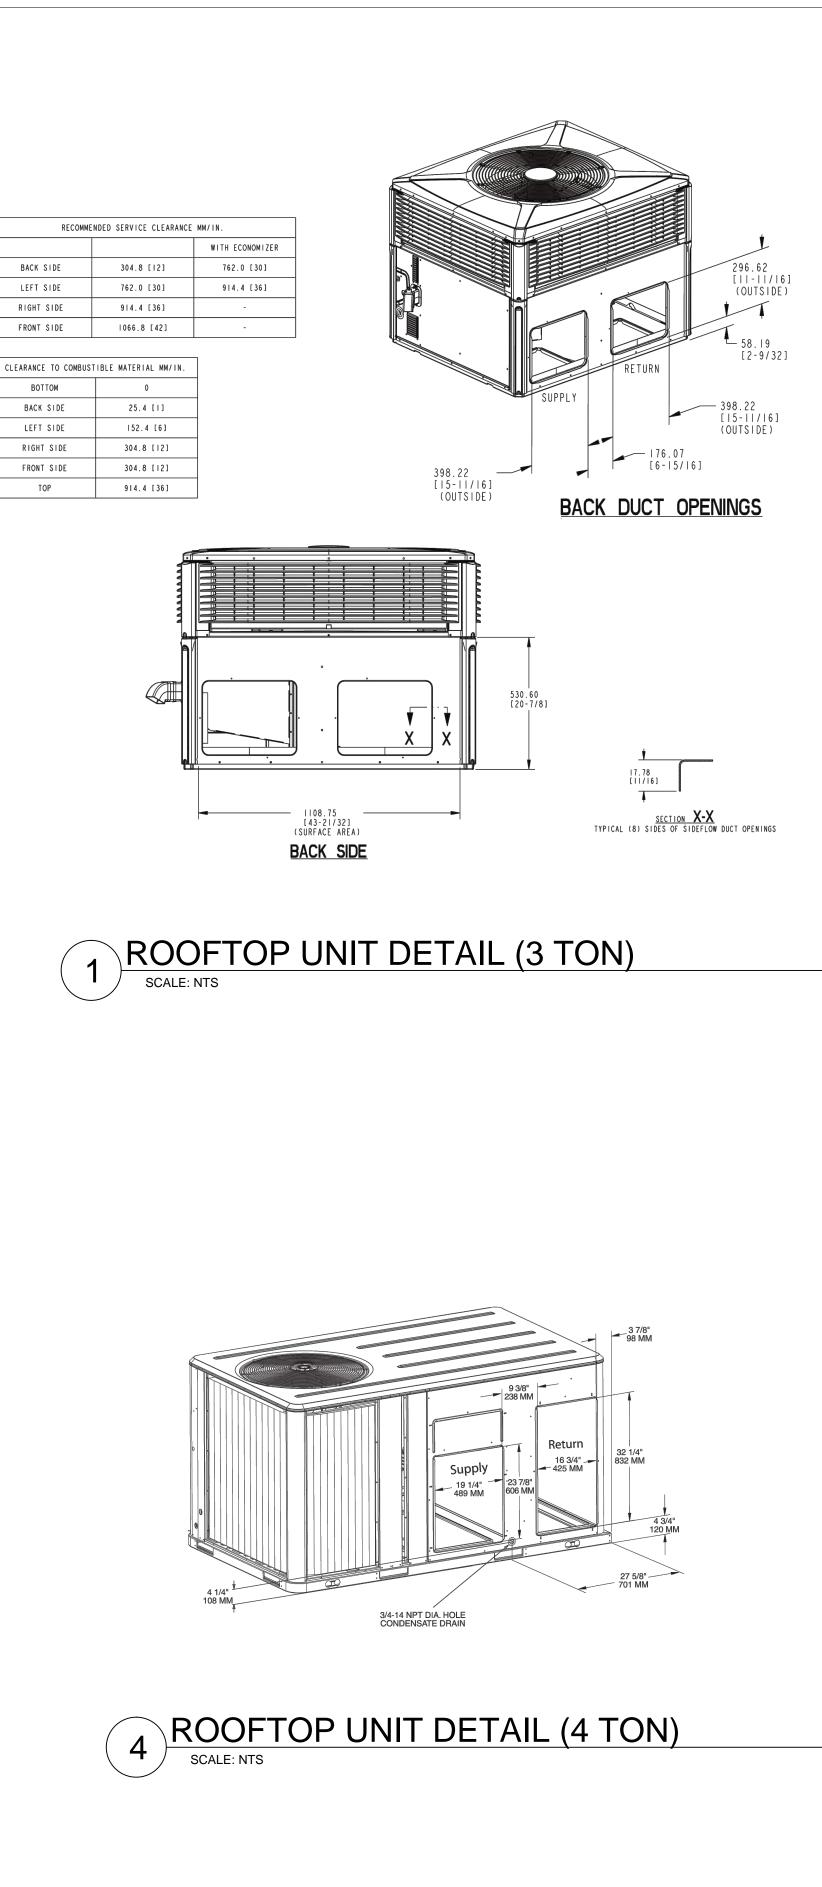

Donald L. Welch Architect 7533 Sandy Land Lane Midvale, Utah 84047 801.548-6391 dwelch5977®msn.com
THE DESIGNS SHOWN AND DESCRIBED HEREIN NCLUDING ALL TECHNICAL DRAWINGS, GRAPHIC REPRESENTATION & MODELS THEREOF, ARE PROPRIETARY & CAN NOT BE COPIED, DUPLICATED, OR COMMERCIALLY EXPLOITED IN WHOLE OR IN PART WITHOUT THE SOLE AND EXPRESS WRITTEN PERMISSION FROM DONALD L. WELCH ARCHITECT THESE DRAWINGS ARE AVAILABLE FOR JMITED REVIEW AND EVALUATION BY CLIENTS CONSULTANTS, CONTRACTORS, GOVERNMENT AGENCIES, VENDORS, AND OFFICE PERSONNEL
DNLY IN ACCORDANCE WITH THIS NOTICE.
Tenant Finish for New Brighton Recovery Campus 4905, 4911, 4915, 4925, 4931, & 4953 South 900 East Salt Lake County, Utah
February 24, 2017 February 24, 2017 Fermit Set-December 28, 2016 ADDENDUM #1-January 04, 2017 ADDENDUM #3-January 11, 2017 ADDENDUM #4-January 17, 2017 ADDENDUM #5-January 20, 2017 ADDENDUM #7-February 24, 2017 data project no:
drawn by: checked by: title MECHANICAL DETAILS sheet M13
BUILDING 'B'

SYN	MBOL LEGEND
SYMBOL	DESCRIPTION
PLUMBING PIPING	
W	SOIL, WASTE - ABOVE GRADE
W	SOIL, WASTE - BELOW GRADE
GW	GREASE WASTE - ABOVE GRADE
GW	GREASE WASTE - BELOW GRADE
	VENT
	COLD WATER
	HOT WATER
	HOT WATER CIRCULATE
ST	STORM - ABOVE GRADE
ST	STORM - BELOW GRADE
OST	OVERFLOW STORM ABOVE GRADE
OST	OVERFLOW STORM BELOW GRADE
VTR	VENT THRU ROOF
(E)	EXISTING PIPE
<i></i> (E)	EXISTING PIPE TO BE REMOVED
G	GAS

SYMBOL	DESCRIPTION
ALVES, METERS	S, AND GAUGES
	SHUT OFF VALVE
——————————————————————————————————————	GATE VALVE
	CHECK VALVE
	AUTO 2-WAY VALVE
	AUTO 3-WAY VALVE
	GLOBE VALVE
φ	BALL VALVE
	RELIEF VALVE
	CHAIN OPERATED GATE VALVE
	PRESSURE REDUCING VALVE
	BUTTERFLY VALVE
	SOLENOID VALVE
	ANGLE VALVE
	VENTURI
	BALANCING OR PLUG COCK
	FLOW SETTER
	EXPANSION VALVE (REFRIG.)
	GAS COCK
¥маv	MANUAL AIR VENT
	STRAINER
 ~	GAUGE COCK
'	FLEXIBLE CONNECTION
 	PRESSURE GAUGE
 []	THERMOMETER
I	VICTAULIC COUPLING
 D	REDUCER CONCENTRIC
	REDUCER ECCENTRIC
 	REFRIGERANT SITE GLASS
	REFRIGERANT STRAINER
	REFRIGERANT FILTER DRIER
	90° ELBOW UP
	90° ELBOW DOWN
	90° TEE UP
	90° TEE DOWN
	UNION
X	
	FLOAT AND THERMOSTATIC TRAP
С.В.	
() м.н.	MANHOLE
	WALL HYDRANT
— H.B.	HOSE BIBB
— — —	CLEANOUT TO GRADE
Φ	FLOOR CLEANOUT
———————————————————————————————————————	WALL CLEANOUT
· ·	
	1/2 GRATE

ABBREVIATIONS NOTE: ALL ABBREVIATIONS MAY NOT BE USED ACCESS DOOR MCA MINIMUM CIRCUIT AMPS AD MANUFACTURER MFR AC AIR CONDITION(-ING,-ED) APD AIR PRESSURE DROP MIN MINIMUM BD BHP BALANCING DAMPER N/A NOT APPLICABLE NC BRAKE HORSE POWER NORMALLY CLOSED BTU BRITISH THERMAL UNIT NC NOISE CRITERIA BTUH **BTU/HOUR** NOT IN CONTRACT NIC CFH CUBIC FEET PER HOUR NORMALLY OPEN NO CFM CUBIC FEET PER MINUTE NPSH NET POSITIVE SUCTION HEAD CLG COOLING NTS NOT TO SCALE COMP COMPONENT OA OUTSIDE AIR COND CONDENS(-ER, -ING, -ATION) OD OUTSIDE DIAMETER CV OZ CONTROL VALVE OUNCE CW COLD WATER PD PRESSURE DROP PROPYLENE GLYCOL DIA DIAMETER PG DISCH DISCHARGE PHASE PH PARTS PER MILLION DP DEPTH OR DEEP PPM DB DRY BULB TEMPERATURE PRESS PRESSURE POUNDS PER SQUARE FOOT (E) EXISTING PSF POUNDS PER SQUARE INCH EER ENERGY EFFICIENCY RATIO PSI EFF EFFICIENCY PSIA PSI ABSOLUTE EG ETHYLENE GLYCOL PSIG PSI GAUGE ELEC ELECTRIC THERMAL RESISTANCE R ELEV ELEVATION **RETURN AIR** RA ENT ENTERING RECIRC RECIRCULATE EVAPORAT(-E, -ING, -ED, -OR) REFR REFRIGERATION EVAP EWT ENTERING WATER TEMP REQD REQUIRED EXT EXTERNAL RPM **REVOLUTIONS PER MINUTE** (F) FUTURE RW RAINWATER FAHRENHEIT SA SUPPLY AIR SC FC FLEXIBLE CONNECTION SHADING COEFFICIENT FIRE DAMPER SCW SOFT COLD WATER FD SF FLA FULL LOAD AMPS SAFETY FACTOR FPI FINS PER INCH SH SENSIBLE HEAT SL SP FPM FEET PER MINUTE SEA LEVEL FEET PER SECOND FPS STATIC PRESSURE FSD SPEC FIRE SMOKE DAMPER SPECIFICATION FT FEET SQ SQUARE STANDARD GAL GALLON(S) STD GPH GALLONS PER HOUR STM STEAM GPM TEMP TEMPERATURE GALLONS PER MINUTE HD TEMP. DROP OR DIFF. HEAD TD HG TOT MERCURY TOTAL HR HOUR TSTAT THERMOSTAT HT HEIGHT V VENT HTG HEATING VAC VACUUM HORSE POWER VAV VARIABLE AIR VOLUME HP HOT WATER VELOCITY HW VEL HZ VENT, VENTILATION HERTZ(FREQUENCY) VENT ID INSIDE DIAMETER VERT VERTICAL VOLUME IN INCH VOL KW KILOWATT WC WATER COLUMN LEAVING AIR TEMPERATURE WG LAT WATER GAUGE WATER PRESSURE DROP LBS POUNDS WPD LG LENGTH WATER WTR LATENT HEAT WEIGHT LH WT LRA WB WET BULB TEMP LOCKED ROTOR AMPS LVG LEAVING LWT LEAVING WATER TEMP MAX MAXIMUM MBH THOUSAND BTU PER HOUR SYMBOL LEGEND SYMBOL DESCRIPTION REFERENCE AND LINE SYMBOLS DETAIL INDICATOR: # INDICATES DETAIL NUMBER, # SHEET INDICATES DRAWING SHEET WHERE DETAIL IS SHEET/ SHOWN. \smile 100 ROOM OR SPACE NUMBER. $\langle 1 \rangle$ KEYNOTE INDICATOR. REVISION INDICATOR. CU-1 EQUIPMENT INDICATOR. (P-) PLUMBING FIXTURE INDICATOR. TYPE CFM SIZE DIFFUSER/GRILLE INDICATOR. TYPE SIZE DIFFUSER/GRILLE INDICATOR. _____ BREAK, STRAIGHT BREAK, ROUND. MATCH LINE MATCH LINE INDICATOR SEE XX/X-XXX HIDDEN FEATURES LINE: HIDDEN, THIN LINE. ____ CONTRACT LIMIT LINE: DASHDOT, WIDE LINE. ____ · ____ NEW CONNECTION POINT TO

EXISTING

PLUMBING SCOPE OF WORK	
DEMOLITION NOTES: PLUMBING CONTRACTOR TO UTILIZE SELECTIVE DEMOLITION APPROACH. MANY AREAS INCLUDE PLUMBING EQUIPMENT AND ACCESSORIES LOCATED ABOVE HARDLID CEILINGS OR WITHIN INACCESSIBLE SPACES. FIELD TRACING	Arch Sandy ale, U h5977
OF DEMOLITION IS REQUIRED. ALL EXISTING PLUMBING FIXTURES AND ACCESSORIES ARE TO BE REMOVED TO ALLOW FOR NEW TENANT SPACES. ALL PLUMBING EQUIPMENT, FIXTURES, PIPING, AND ACCESSORIES THAT ARE CURRENTLY ABANDONED IN PLACE ARE TO BE REMOVED.	D 7533 (Midv dwelo
ALL STORM WATER / ROOF DRAINAGE PIPING WITHIN THE BUILDING IS TO REMAIN UNCHANGED.	
EXISTING GAS METERS TO REMAIN. EXISTING GAS PIPING SEGMENTS MAY BE REUSED IF SIZING AND ROUTING ARE SIMILAR TO NEW PIPING LAYOUT. PUBLIC UTILITY COMPANY TO VERIFY NATURAL GAS CAPACITIES AND ASSOCIATED PRESSURES.	
CAP/REPLACE ALL WASTE AND VENT LINES BACK TO NEAREST MAIN TO ALLOW FOR FUTURE CONNECTIONS.	
NEW CONSTRUCTION NOTES:	
NEW WATER ENTRIES WILL BE INSTALLED AS INDICATED ON PLANS. ALL DOMESTIC COLD WATER AND FIRE WATER PIPING SEGMENTS EXPOSED TO ENVIRONMENT ARE TO BE INSULATED AND HEAT TRACED FOR FREEZE PROTECTION.	THE DESIGNS SHOWN AND DESCRIBED HERI NCLUDING ALL TECHNICAL DRAWINGS, GRAPHIC REPRESENTATION & MODELS THEREOF, ARE PROPRIETARY & CAN NOT I
ALL EXISTING STORM DRAIN TERMINATIONS ARE TO CONNECT TO CIVIL DRAINAGE SYSTEM.	Copied, Duplicated, or commercially Exploited in whole or in part without The sole and express written Permission from donald L. Welch
ALL GREASE WASTE PIPING DESIGNATED TO SERVE FUTURE WARMING KITCHEN WILL TIE INTO NEW GREASE INTERCEPTOR AS SHOWN ON CIVIL DRAWINGS. A VENT LINE FOR THE GREASE INTERCEPTOR WILL BE PROVIDED AND WILL TERMINATE THROUGH ROOF OF BUILDING 'D'.	ARCHITECT THESE DRAWINGS ARE AVAILABLE FOR LIMITED REVIEW AND EVALUATION BY CLIEN CONSULTANTS, CONTRACTORS, GOVERNMEN AGENCIES, VENDORS, AND OFFICE PERSON
THE NEW SYSTEM COMPONENTS WILL ALLOW FOR FUTURE OFFICE AND TEMPORARY RESIDENT SPACES AS INDICATED ON PLANS.	ONLY IN ACCORDANCE WITH THIS NOTICE.
DOMESTIC WATER, WASTE, AND GREASE WASTE LINES (AS APPLICABLE) WILL BE PROVIDED TO EACH BUILDING AS INDICATED.	consultant:
HEATING OF DOMESTIC WATER WILL BE PROVIDED BY INDIVIDUAL BUILDING WATER HEATERS.	PROFESS/ON
DOMESTIC COLD WATER SUBMETERS TO BE INSTALLED IN EACH BUILDING'S WATER ENTRY ROOM. VERIFY NEED WITH OWNER PRIOR TO INSTALLATION.	03-21-2017 4 No. 9520491 5 BENJAMIN J. SCHLUP
EW FIRE ENTRIES TO BE INSTALLED AS INDICATED ON PLANS. RE PROTECTION LINES TO BE ROUTED ON WARM SIDE OF BUILDING INSULATION. ISTALL FIRE PROTECTION SYSTEM PER NOTES INDICATED ON P02 OF THIS RAWING SET. LL BREEZEWAY SOFFITS TO INCORPORATE DRY PIPE FIRE PROTECTION SYSTEM ED FROM FIRE ENTRY ROOM PIPING AS REQUIRED. ITHE EVENT THAT ROUTING MAY PROVE DIFFICULT DUE TO EXISTING ONDITIONS A DRY-PIPE SYSTEM SHOULD BE EVALUATED. LOCATE AIR ONDITIONS A DRY-PIPE SYSTEM SHOULD BE EVALUATED. EE SHEET P02 (SPEC SECTION 221316) AND SHEET P13 FOR FURTHER SYSTEM EQUIREMENTS & DETAILS. IVISION 26 CONTRACTOR TO PROVIDE POWER TO ASSOCIATED SYSTEM FLOW WITCH.	Tenant Finish for New Brighton Recovery Campus 4905, 4911, 4915, 4925, 4931, & 4953 South 900 East Salt Lake County Utah date February 24, 201 revisions PERMIT SET-December 28, 201 ADDENDUM #1-January 04, 201 ADDENDUM #3-January 11, 201 ADDENDUM #5-January 20, 201 ADDENDUM #5-January 20, 201
	data project no: drawn by: checked by: title PLUMBING GENERAL NOTES & LEGEND sheet
	P01

n 7

	PLUMBING SPECIFICATIONS 00 - BASIC PIPING MATERIALS & METHODS
1.	CORE CUT ALL PIPE PENETRATION OF EXISTING MASONRY OR CONCRETE WALLS AND FLOORS. SLEEVE ALL PENETRATIONS THROUGH NEW WALLS AND FLOORS. SEAL ALL PENETRATIONS WATER TIGHT WITH SILICONE SEALANT. USE FIRE RATED SEALANT (3M "FIRE BARRIER" OR EQUAL) FOR 1 HOUR OR 2 HOUR PENETRATIONS.
2.	CAULK AROUND ALL PIPING THAT PASSES THROUGH FIRE-RATED PARTITIONS WITH A NON-HARDENING CAULKING SIMILAR TO 3M "FIRE BARRIER".
3.	SEAL ALL PIPING THROUGH WALLS AIR TIGHT.
2205	33 - HEAT TRACING CABLE
1.	PROVIDE RAYCHEM ELECTRIC SELF REGULATING HEATING CABLE WITH ALL NECESSARY ACCESSORIES TO MAINTAIN THE TEMPERATURE IN THE TRACED PIPE SYSTEM AT 45°F.
2.	FOR DOMESTIC HOT WATER USE, THE CABLE SHALL BE DESIGNED, MANUFACTURED AND U.L. LISTED FOR DOMESTIC HOT WATER TEMPERATURE MAINTENANCE.
3.	CABLE SHALL CONSIST OF TWO (2) 16-AWG NICKEL-COATED COPPER BUS WIRES EMBEDDED IN A RADIATION-CROSSLINKED CONDUCTIVE POLYMER CORE. IT SHALL BE COVERED BY A RADIATION-CROSSLINKED, POLYOLEFIN, DIELECTRIC JACKET SURROUNDED BY A POLYMER-COATED ALUMINUM WRAP, AND ENCLOSED IN A TINNED COPPER BRAID OF 14 AWG EQUIVALENT WIRE SIZE. THE BRAID SHALL BE COVERED WITH A (NOMINAL) 40-MIL POLYOLEFIN OUTER JACKET, COLOR CODED FOR EASY IDENTIFICATION.
2205	48 - VIBRATION ISOLATION AND SEISMIC
1.	ALL PLUMBING EQUIPMENT AND PIPING MUST BE VIBRATION ISOLATED AND SEISMICALLY BRACED FOR THE SITE SPECIFIC SEISMIC DESIGN CATEGORY AND SEISMIC USE GROUP, IN ACCORDANCE WITH THE LATEST ADOPTED EDITIONS OF THE BUILDING CODES AND ASHRAE. PROVIDE SEISMIC PRODUCTS BY AMBER-BOOTH OR MASON INDUSTRIES.
2.	IN GENERAL, PROVIDE SPRING MOUNTS TO ATTENUATE LOW FREQUENCY SOUND AND VIBRATION. PROVIDE NEOPRENE PADS TO ATTENUATE HIGH FREQUENCY SOUND
3.	VIBRATION: SEISMIC BRACING/MOUNTING CAN BE COMBINED WITH VIBRATION ISOLATION AS APPLICABLE.
4.	CONTRACTOR MANUFACTURED SEISMIC BRACING/RESTRAINT METHODS ARE NOT ACCEPTABLE.
5.	PROVIDE A SIGNED AND STAMPED LETTER FROM A PROFESSIONAL ENGINEER CERTIFYING THAT THE SUPPLIED PRODUCTS ARE CORRECT FOR THE APPLICATION AND THAT THE INSTALLATION IS IN COMPLIANCE WITH ALL APPLICABLE CODES.
2207	19 - INSULATION
1.	PIPE INSULATION: SNAP-ON GLASS FIBER TYPE WITH VAPOR JACKET. SEAL ALL ENDS AND JOINTS TO PROVIDE A COMPLETELY SEALED SYSTEM. ALTERNATIVELY, FOR INTERIOR WATER PIPING, USE FLEXIBLE UNICELLULAR ASTM 534 TYPE 1 INSULATION. USE 1" THICKNESS FOR PIPE UP TO 2"Ø AND 1-1/2" FOR PIPE OVER 2"Ø
2.	PROVIDE ADA COMPLIANT FIXTURES WITH SNAP ON ADA ARTICLE 4.19 22FF COMPLIANT WHITE INSULATION. TRUEBRO LAV GUARD, BASIN GUARD OR LAV SHIELD.
3.	THERMAL AND SOUND INSULATION AND COVERING WHICH ARE INSTALLED AND EXPOSED SPACES AND COVERING PIPE AND TUBING SHALL BE TESTED IN ACCORDANCE WITH ASTM E 84 AND HAVE A FLAME SPREAD OF 0-25 AND A SMOKE INDEX OF 0-450.
4.	THERMAL AND SOUND INSULATION AND COVERING OVER PIPE AND TUBING WHICH ARE INSTALLED IN CONCEALED PLENUM SPACES SHALL BE TESTED IN ACCORDANCE WITH ASTM E 84 AND HAVE A FLAME SPREAD OF 0-25 AND A SMOKE INDEX OF 0-50.
2211	16 - WATER DISTRIBUTION PIPING
1.	UNDERGROUND WATER PIPING:
	2" AND SMALLER: ASTM 88 TYPE "K" COPPER WITH A MINIMUM NUMBER OF SOLDERED JOINTS. USE 95-5 TIN ANTIMONY COPPER SOLDER.
	2-1/2" AND LARGER: PVC AWWA 900 CLASS 100 WITH SOLVENT CEMENTED JOINTS, OR PB PLASTIC PIPE ASTM D3309 SDR 11 WITH HEAT FUSION JOINTS.
2.	NO TYPE "M" OR "DWV" COPPER IS TO BE USED IN THIS PROJECT.
3.	ALL ABOVE GROUND HOT AND COLD WATER PIPING: ASTM B 88 TYPE "L" COPPER, WITH WROUGHT COPPER FITTINGS AND SOLDERED WITH 95-5 TIN-ANTIMONY SOLDER.
4.	INSTALL PIPE HANGERS WITH THE FOLLOWING MINIMUM ROD SIZES AND MAXIMUM SPACING. UPON COMPLETION OF HANGER INSTALLATION, ALL ADJUSTMENTS HAVING THE POSSIBILITY OF TURNING SHALL BE LOCKED SECURELY IN PLACE BY DOUBLE NUTTING AT THE HANGER ROD ATTACHMENT TO THE STRUCTURE, AND AT THE PIPE HANGER.
	NOM. PIPEMAXMIN. RODSIZE-INCHESSPAN-FT.SIZE-INCHES173/8
	1-1/2 9 3/8 2 10 3/8 3 12 1/2 4 14 5/8
5.	6 17 3/4 ALL PIPE HANGERS AND EQUIPMENT SUPPORTS SHALL BE LOCATED A
6.	MINIMUM DISTANCE OF 2" FROM ANY REFRIGERANT PIPE. ALL PLUMBING FIXTURES CONNECTED TO A POTABLE WATER SYSTEM
0.	WITH HOSE CONNECTIONS ON THE OUTLET SIDE AND OWNER FURNISHED EQUIPMENT WITH DIRECT CONNECTIONS, SHALL BE

PLUMBING SPECIFICA 221316 - DRAINAGE AND VENT SYSTEMS

- 1. UNDERGROUND BUILDING DRAIN PIPE AND FITTINGS: A. NO HUB ABS OR PVC PLASTIC PIPE AND FITTINGS PER ASTM D2661 WITH ASTM D2235 SOLVENT OR
 - B. ASTM A74 SERVICE WEIGHT, HUB AND SPIGOT CAST IRON SOIL PIPE, OR ASTM A888 (OR CISPI 301) HUBLESS CAST IRON SOIL PIPE WITH ASTM C564 HEAVY DUTY SHIELDED STAINLESS STEEL COUPLINGS.
- A. NO ASTM D2729 PIPE SHALL USED UNDERGROUND.
- ABOVE GROUND SANITARY DRAINAGE AND VENT PIPING, IN ALL AREAS EXCEPT AIR PLENUMS AND EXCEPT IN A FIRE RATED BUILDING, SHALL BE ABS TYPE DWV PLASTIC PIPE AND FITTINGS PER ASTM D2661 WITH ASTM D2255 SOLVENT, OR PVC PLASTIC PIPE AND FITTINGS PER ASTM D2665 WITH ASTM D2564 SOLVENT, OR SERVICE WEIGHT, NO HUB CAST IRON COUPLED PIPE AND FITTINGS WITH COMPRESSION TYPE NEOPRENE GASKETS AND STAINLESS STEEL BANDS.
- FORCE SEWER MAINS UP TO 4" SHALL BE TYPE L HARD COPPER TUBE WITH WROUGHT COPPER PRESSURE FITTINGS AND SOLDERED JOINTS, OR DUCTILE IRON PIPE AND FITTINGS WITH MECHANICAL JOINTS.
- 4. ALL SANITARY DRAINAGE AND VENT PIPING INSIDE AIR PLENUMS AND ANYWHERE IN A FIRE RATED BUILDING SHALL BE NO HUB SERVICE WEIGHT CAST IRON COUPLED PIPE AND FITTINGS WITH COMPRESSION TYPE NEOPRENE GASKETS AND STAINLESS STEEL BANDS. ASTM B306 COPPER PIPE MAY BE USED WITH SOLDERED JOINTS FOR PIPE 3" AND SMALLER.
- ABOVE GROUND ROOF DRAIN LINES, EXCEPT IN AIR PLENUMS AND ANYWHERE IN A FIRE RATED BUILDING, SHALL BE ABS TYPE DWV PLASTIC PIPE AND FITTINGS PER ASTM D2661 WITH ASTM D2255 SOLVENT, OR PV C PLASTIC PIPE PER ASTM D2665 WITH ASTM D2564 SOLVENT.
- ALL ROOF DRAIN LINES INSIDE AIR PLENUMS, OR ANYWHERE IN A FIRE RATED BUILDING, SHALL BE SERVICE WEIGHT CAST IRON PIPE TO CISPI STANDARD 301.
- 7. ALL ROOF DRAIN LINES SHALL BE FULLY INSULATED.
- 8. OVERFLOW ROOF DRAINS SHALL DAYLIGHT 18" ABOVE THE SURROUNDING HORIZONTAL AREA.
- 9. INSTALL SANITARY DRAIN LINES 2-1/2" AND LESS WITH A SLOPE OF 2%. INSTALL SANITARY DRAIN LINES 3"-6" WITH A SLOPE OF NOT LESS THAN 1%.
- 10. SLOPE ROOF DRAIN LINES DOWN IN DIRECTION OF FLOW, 1/8" PER FOOT (1%).
- 11. CLEANOUTS
- A. FINISHED WALL CLEANOUTS: SMITH FIGURE 4472 COMPLETE WITH CAST BRONZE TAPER THREADED PLUG, STAINLESS STEEL COVER AND SCREW.
- B. FLOOR CLEANOUTS (UNFINISHED AREAS): SMITH FIGURE 4223 DUCO CAST IRON CLEANOUT WITH ROUND ADJUSTABLE SCORIATED SECURED CAST IRON TOP, TAPER THREADED BRONZE PLUG AND SPIGOT OUTLET.
- C. FINISHED FLOOR CLEANOUTS (CONCRETE FLOORS): SMITH FIGURE 4023 DUCO CAST IRON CLEANOUT WITH ADJUSTABLE SCORIATED SECURED NICKEL BRONZE TOP, TAPER THREADED CAST BRONZE PLUG AND SPIGOT OUTLET.
- D. FINISHED FLOOR CLEANOUTS (CARPETED FLOORS): SMITH FIGURE 4023-Y SAME AS CONCRETE FLOORS WITH CARPET MARKER. FINISHED FLOOR CLEANOUTS (TILE FLOORS): SMITH FIGURE 4163
- DUCO CAST IRON CLEANOUT WITH SQUARE ADJUSTABLE SECURED NICKEL BRONZE TOP WITH 1/8" RECESS, TAPER THREADED BRONZE PLUG AND SPIGOT OUTLET.
- F. EXTERIOR CLEANOUTS (CLEANOUT TO GRADE): SMITH FIGURE 4253 DUCO CAST IRON CLEANOUT AND DOUBLE FLANGED HOUSING WITH HEAVY DUTY SECURED SCORIATED CAST IRON COVER WITH LIFTING DEVICE. TAPER THREADED BRONZE PLUG AND SPIGOT OUTLET.
- 12. FLOOR DRAINS:

FD-1 FLOOR DRAIN: SMITH FIGURE 2010-BP CAST IRON BODY AND FLASHING COLLAR WITH PROTECTIVE CAP AND SQUARE NICKEL BRONZE ADJUSTABLE STRAINER HEAD WITH SECURED SQUARE HOLE GRATE, AND TRAP PRIMER CONNECTION.

FD-2 MECHANICAL ROOM DRAIN: SMITH FIGURE 2110-NB MEDIUM DUTY FLOOR DRAIN. CAST IRON BODY AND FLASHING COLLAR WITH NICKEL BRONZE BAR GRATE.

13. ROOF DRAINS (AS REQUIRED IF REPLACEMENT IS NECESSARY)

RD-1 ROOF DRAIN: SMITH FIGURE 1010-ERC CAST IRON BODY WITH COMBINED FLASHING CLAMP AND CAST IRON GRAVEL STOP, CAST IRON DOME, EXTENSION, SUMP RECEIVER AND UNDERDECK CLAMP.

ORD-1 OVERFLOW ROOF DRAIN: SMITH FIGURE 1080-ERC CAST IRON BODY WITH FLASHING CLAMP, GRAVEL STOP, CAST IRON DOME, 2" HIGH CAST IRON WATER COLLAR, EXTENSION, SUMP RECEIVER AND UNDERDECK CLAMP.

DSN-1 DOWNSPOUT NOZZLE:SMITH FIGURE 1770 DOWNSPOUT NOZZLE. CAST BRONZE BODY AND FLANGE. PROVIDE BRONZE BOLTS TO SECURE NOZZLE TO WALL. INSTALL 12" ABOVE FOUNDATION UNLESS NOTED OTHERWISE.

14. FIRE/WATER ENTRIES

FIRE ENTRY: WATTS 757DCDA OSY OR EQUAL. DOUBLE CHECK DETECTOR ASSEMBLY. TWO INDEPENDENTLY OPERATING TRI-LINK CHECK VALVES, TWO SHUTOFF VALVES, AND FOUR TEST COCKS. STAINLESS STEEL HOUSING AND SLEEVE. MAXIMUM WORKING PRESSURE: 175PSI. PROVIDE FLOW SWITCH WITH LINE VOLTAGE POWER.

DOMESTIC WATER ENTRY: WATTS LF909 OR EQUAL. LEAD FREE REDUCED PRESSURE ZONE ASSEMBLY. HORIZONTAL OR VERTICAL (UP OR DOWN) INSTALLATION, TEMPERATURE RANGE: 33°F – 140°F, MAXIMUM WORKING PRESSURE: 175PSI, TEMPERATURE RANGE: 33°F – 210°F, MAXIMUM WORKING PRESSURE: 175PSI (FOR MAIN SERVICE WATER ENTRY APPLICATIONS)

DOMESTIC WATER DOUBLE CHECK: WATTS LF719 OR EQUAL. LEAD FREE DOUBLE CHECK VALVE ASSEMBLY. SEPARATE ACCESS, TOP ENTRY CHECK VALVE, REVERSIBLE SEAT DISC RUBBER, VALVE TEST COCKS, TEMPERATURE RANGE: 33°F – 180°F, MAXIMUM WORKING PRESSURE: 175PSI (FOR APPLICATIONS DOWNSTREAM OF WATER ENTRY PRESSURE REDUCING VALVE)

TIONS	
-------	--

PLUMBING SPECIFICATIONS

221613 - NATURAL GAS SYSTEMS

- 1. NATURAL GAS PIPING ABOVE GROUND OR INSIDE BUILDINGS: SCHEDULE 40 BLACK STEEL WITH WELDED OR MALLEABLE IRON FITTINGS
- UNDERGROUND GAS PIPE: EITHER POLYETHYLENE ASTM D2513, OR 2. SCHEDULE 40 BLACK STEEL PRIMED AND WRAPPED IN ACCORDANCE WITH LOCAL GAS COMPANY REQUIREMENTS.
- 3. GAS MAINS INSIDE BUILDINGS ARE SIZED FOR 2 PSIG PRESSURE. LOCATE PRESSURE REGULATORS AS SHOWN ON THE DRAWINGS TO REDUCE PRESSURE FROM 2 PSIG TO 7" W.C. PROVIDE FULL SIZE VENT LINES FROM GAS PRESSURE REGULATORS AND EXTEND TO OUTSIDE OR THROUGH ROOF. FLASH PENETRATIONS AND MAKE WATER TIGHT. INSTALL VENTLESS GAS REGULATOR AS ALTERNATE.
- 4. PROVIDE GAS SHUT OFF VALVE AT EACH PIECE OF GAS UTILIZING EQUIPMENT.
- 5. THE EQUIPMENT INSTALLER SHALL APPLY AND SIGN A CERTIFICATION LABEL TO EACH GAS-FIRED APPLIANCE, STATING THE APPLIANCE HAS BEEN ADJUSTED OR MODIFIED PER MANUFACTURER'S REQUIREMENTS FOR OPERATION AT THE PROJECT ALTITUDE AND WITH THE BTU-CONTENT OF THE AVAILABLE FUEL-GAS.

223000 - WATER HEATERS

PRESSURE.

- INSTALL UNITS PLUMB AND LEVEL AND FIRMLY ANCHORED PER SEISMIC REQUIREMENTS. MAINTAIN MANUFACTURER'S RECOMMENDED CLEARANCES. ORIENT SO CONTROLS AND DEVICES NEEDING SERVICING ARE ACCESSIBLE.
- CONNECT HOT AND COLD WATER PIPING TO UNITS WITH SHUT-OFF 2. VALVES AND UNIONS. CONNECT HOT WATER CIRCULATING PIPING TO UNIT WITH SHUT-OFF VALVE, CHECK VALVE AND UNION.
- USE DIELECTRIC FITTINGS AND UNIONS WHERE PIPING CONNECTIONS ARE DISSIMILAR METALS.
- 4. INSTALL VACUUM RELIEF VALVE IN COLD WATER INLET PIPING. EXTEND RELIEF VALVE DISCHARGE TO CLOSEST FLOOR DRAIN. INSTALL DRAIN AS INDIRECT WASTE TO SPILL INTO OPEN DRAIN OR OVER FLOOR DRAIN.
- PROVIDE AND INSTALL EXPANSION TANK AS SCHEDULED IN DRAWINGS. 5. EXPANSION TANK: DIAPHRAGM TYPE, PRE- PRESSURIZED STEEL TANK WITH RELIEF VALVE SETTING @ 120 PSI MAXIMUM
- CONNECT GAS SUPPLY PIPING TO BURNER WITH DRIP LEG, TEE, GAS 6. COCK, AND UNION, MINIMUM SIZE SAME AS INLET CONNECTION. INSTALL GAS PRESSURE REGULATORS WHERE INDICATED.
- CONNECT OIL PIPING TO OIL BURNER WITH SHUT-OFF VALVE AND UNION IN SUPPLY AND CHECK VALVE AND UNION IN RETURN PIPING.
- 8. ELECTRICAL CONNECTIONS: POWER WIRING AND DISCONNECT SWITCHES ARE SPECIFIED IN DIVISION 16. CONNECT UNIT COMPONENTS TO GROUND IN ACCORDANCE WITH THE NATIONAL ELECTRICAL CODE.
- 9. VENT CONNECTIONS: CONNECT GAS FIRED WATER HEATER DRAFT HOOD TO VENT SYSTEM. UNLESS OTHERWISE INDICATED, PROVIDE VENT SAME SIZE AS OUTLET ON HEATER. COMPLY WITH GAS UTILITY REQUIREMENTS.
- 10. CONNECT OIL-FIRED WATER HEATER VENT AND DRAFT REGULATOR TO VENT SYSTEM. PROVIDE VENT AND DRAFT REGULATOR SAME SIZE AS OUTLET ON HEATER.
- 11. PROVIDE SEALED COMBUSTION SYSTEMS WITH CONNECTIONS FOR OUTSIDE COMBUSTION AIR.
- 12. PROVIDE CONCENTRIC VENT TERMINATION KIT FOR ROOF OR WALL APPLICATIONS.
- 13. PROVIDE PVC COMBUSTION AIR AND VENT PIPING FROM WATER HEATER TO TERMINATION KIT.
- 14. PROVIDE CONDENSATE DRAIN FROM WATER HEATER OR VENT AS REQUIRED.

PLUMBING SPECIFICATI

224213 - PLUMBING FIXTURES


- 1. PROVIDE AND INSTALL CARRIERS AS REQUIRED FOR FLOOR MOUNTED PLUMBING FIXTURES. INSTALL ALL FIXTURES WIT ACCESSORIES AS REQUIRED TO PROVIDE A COMPLETE, WOI INSTALLATION.
- 2. PLUMBING FIXTURES SHALL INCLUDE COMPRESSION STOPS FLOOR IN SUPPLIES TO ALL FIXTURES AND A MINIMUM 17 GAU
- 3. ALL LAVATORIES AND HAND SINKS WILL HAVE A COMBINATIO OR PREMIXING FAUCET CAPABLE OF SUPPLYING WARM WAT MINIMUM OF 10 SECONDS.
- 4. ALL JANITORIAL SINK FAUCETS MUST BE PROVIDED WITH AN APPROVED BACKFLOW PREVENTION DEVICE.
- 5. FLOOR DRAINS AND FLOOR SINKS ARE SHOWN IN THE APPR LOCATION. COORDINATE FINAL LOCATION WITH EQUIPMENT DRAINAGE REQUIREMENTS. PROVIDE BLOCKOUTS AS NECES

FIRE SPRINKLER SY

THESE DRAWINGS AND SPECIFICATIONS ARE FOR THE FIRE PROTECT SYSTEM, PER THE DESIGN INTENT AS SHOWN.

- CONTRACTOR TO PROVIDE A HYDRAULICALLY-DESIGNED, FUSIB SPRINKLED, WET PIPE FIRE PROTECTION SYSTEM FOR BUILDING SUBJECT TO FREEZING.
- 2. CONTRACTOR TO PROVIDE A HYDRAULICALLY-DESIGNED, FUSIB SPRINKLED, DRY PIPE OR GLYCOL FIRE PROTECTION SYSTEM E SUBJECT TO FREEZING, INCLUDING PARKING GARAGES, ENTRAN OVERHANGS.
- ALL DESIGN SHALL BE IN ACCORDANCE WITH THE LATEST ADOPT 3. THE BUILDING CODE, FIRE CODE, MECHANICAL CODE, PLUMBING OTHER LOCAL, STATE, OR FEDERAL REGULATIONS AND CODES, INSTRUCTIONS FROM THE AUTHORITY HAVING JURISDICTION.
- 4. SUBMIT FIRE PROTECTION LAYOUT DRAWINGS AND CALCULATIO ENGINEER FOR GENERAL APPROVAL OF SYSTEM LAYOUT, LOCAT COMPONENTS ETC. THEN SUBMIT TO THE FIRE MARSHALL HAVIN AND OBTAIN APPROVAL. CONTRACTOR TO PAY ALL PERMIT/APPI FEES AND COSTS INVOLVED.
- 5. SYSTEM DESIGN SHALL BE BASED ON THE FOLLOWING CRITERIA
- LIGHT HAZARD IN ALL AREAS; EXCEPT ORDINARY HAZARD GI 5.1.
- KITCHEN AREA. DESIGN THE SYSTEM USING THE AREA/DENSITY METHOD IN 5.2. 5.3. FLOW TEST DATA TO BE DETERMINED BY THE FIRE PROTEC CONTRACTOR.
- 6. PROVIDE COVERAGE FOR A SINGLE FIRE ZONE.
- 7. PROVIDE INSPECTOR'S TEST CONNECTION IN A LOCATION APPRO OWNER AND THE FIRE MARSHALL.
- 8. DUE CONSIDERATION SHALL BE GIVEN TO THE LOCATION OF BUI (I.E. BEAMS, COLUMNS, LIGHT FIXTURES, ETC.) IN DETERMINING SPACING AND ARRANGEMENT. THE STRUCTURE SHOWN ON ALL MAY NOT PERTAIN TO A PORTION OR ANY PORTION OF THE BUIL COORDINATE MOUNTING REQUIREMENTS WITH ARCHITECTURAL STRUCTURAL.
- 9. ALL EQUIPMENT, PIPING, COMPONENT, AND ACCESSORY SIZES, TYPES SHOWN IN THESE DRAWINGS AND SPECIFICATIONS SHAL
- 10. AUXILIARY DRAINS SHALL BE INCLUDED AS NECESSARY TO DRAI SYSTEM DISTRIBUTION LINES AND BRANCHES DOWNSTREAM OF VALVE.
- 11. AUTOMATIC AIR RELEASE VALVES SHALL BE FURNISHED AS NEC THE DRY PIPE SPRINKLER SYSTEM. THE VALVES SHALL BE MADE FROM THE SYSTEM WITH APPROPRIATELY SIZED GATE VALVES.
- 12. THE CONTRACTOR SHALL THOROUGHLY TEST, DISINFECT, AND F SYSTEM ACCORDING TO APPLICABLE CODES AND STANDARDS.
- 13. ANY DIMENSIONS SHOWN ARE FOR REFERENCE ONLY. CONTRAC VERIFY ALL DIMENSIONS AND CONNECTIONS REQUIRED FOR INST
- 14. REFER TO ARCHITECTURAL DRAWINGS FOR ADDITIONAL BUILDIN SUCH AS ATTIC SPACES, CONSTRUCTION MATERIALS, SPECIAL L BUILDING SECTIONS, ETC.
- 15. SPRINKLER HEADS:
- SPRINKLER HEADS FOR LIGHT HAZARD CLASSIFICATION S RESPONSE TYPE PER NFPA 13. ALL OTHER CLASSIFICATI STANDARD RESPONSE TYPE.
- GENERAL: ALL HEADS SHALL BE FACTORY MUTUAL APPRO Β. APPLICATION AND INSTALLATION. WET OR DRY TYPE AS I CEILING ESCUTCHEONS MAY BE PLASTIC OR METAL 2 PIE
- C. EXPOSED HEADS IN CEILING: SEMI-RECESSED TYPE WITH CHROME-PLATED ESCUTCHEON CUP, WHEREVER HEADS SURFACE-MOUNTED LIGHTS OR OBSTRUCTIONS, USE EXT HEAD WITH SHALLOW FRICTION ADJUSTABLE ESCUTCHE CHROME-PLATED FINISH. COORDINATE EXTENDED PEND WITH ARCHITECT PRIOR TO PURCHASE OR INSTALLATION

ONS		PENETRATION FIRESTOPPING NOTES	. Welch tect an 84047 -6391 msn.com
OR WALL H RKABLE		1. CONTRACTOR SHALL REVIEW CONSTRUCTION DOCUMENTS AND PROVIDE SPECIFIC FIRESTOPPING DETAILS FROM A SPECIFIC FIRESTOPPING MANUFACTURER FOR EACH MECHANICAL (HVAC) AND PLUMBING PIPE OR DUCT PENETRATION FOR EACH FIRE RATED ASSEMBLY.	dy L Uts 377®
ABOVE LUGE P-TRAP.		2. PROVIDE PENETRATION FIRESTOPPING THAT IS PRODUCED AND INSTALLED TO RESIST SPREAD OF FIRE ACCORDING TO REQUIREMENTS INDICATED, RESIST PASSAGE OF SMOKE AND OTHER GASES, AND MAINTAIN ORIGINAL FIRE-RESISTANCE RATING OF CONSTRUCTION PENETRATED.	Dona Ar 7533 San Midvale, dwelch59
FER FOR A		3. PENETRATION FIRESTOPPING SYSTEMS SHALL BE COMPATIBLE WITH ONE ANOTHER, WITH THE SUBSTRATES FORMING OPENINGS, AND WITH PENETRATING ITEMS IF ANY.	
		4. PENETRATIONS IN FIRE-RESISTANCE-RATED WALLS: PROVIDE PENETRATION FIRESTOPPING WITH RATINGS DETERMINED PER ASTM E 814 OR UL 1479, BASED ON TESTING AT A POSITIVE PRESSURE DIFFERENTIAL OF 0.01-INCH WG	
SSARY.		5. PENETRATION FIRESTOPPING PRODUCTS SHALL BEAR UL, ETL OR FM GLOBAL CLASSIFICATION MARKING OF QUALIFIED TESTING AND INSPECTING AGENCY.	
		6. DO NOT INSTALL PENETRATION FIRESTOPPING WHEN AMBIENT OR SUBSTRATE TEMPERATURES ARE OUTSIDE LIMITS PERMITTED BY PENETRATION FIRESTOPPING MANUFACTURERS OR WHEN SUBSTRATES ARE WET BECAUSE OF RAIN, FROST, CONDENSATION, OR OTHER CAUSES.	THE DESIGNS SHOWN AND DESCRIBED HEREIN NCLUDING ALL TECHNICAL DRAWINGS, GRAPHIC REPRESENTATION & MODELS
		7. COORDINATE CONSTRUCTION OF OPENINGS AND PENETRATING ITEMS TO ENSURE THAT PENETRATION FIRESTOPPING IS INSTALLED ACCORDING TO SPECIFIED REQUIREMENTS.	THEREOF, ARE PROPRIETARY & CAN NOT BE COPIED, DUPLICATED, OR COMMERCIALLY EXPLOITED IN WHOLE OR IN PART WITHOUT THE SOLE AND EXPRESS WRITTEN PERMISSION FROM DONALD L. WELCH
		8. COORDINATE SIZING OF SLEEVES, OPENINGS, CORE-DRILLED HOLES, OR CUT OPENINGS TO ACCOMMODATE PENETRATION FIRESTOPPING.	ARCHITECT These drawings are available for Limited review and evaluation by clients.
		9. INSTALL PENETRATION FIRESTOPPING TO COMPLY WITH MANUFACTURER'S WRITTEN INSTALLATION INSTRUCTIONS AND PUBLISHED DRAWINGS FOR PRODUCTS AND APPLICATIONS INDICATED.	CONSULTANTS, CONTRACTORS, GOVERNMENT AGENCIES, VENDORS, AND OFFICE PERSONNEL ONLY IN ACCORDANCE WITH THIS NOTICE.
		10. INSTALL FORMING MATERIALS AND OTHER ACCESSORIES OF TYPES REQUIRED TO SUPPORT FILL MATERIALS DURING THEIR APPLICATION AND IN THE POSITION NEEDED TO PRODUCE CROSS-SECTIONAL SHAPES AND DEPTHS REQUIRED TO ACHIEVE FIRE RATINGS INDICATED.	consultant:
		11. IDENTIFY PENETRATION FIRESTOPPING WITH PREPRINTED METAL OR PLASTIC LABELS. ATTACH LABELS PERMANENTLY TO SURFACES ADJACENT TO AND WITHIN 6 INCHES OF FIRESTOPPING EDGE SO LABELS WILL BE VISIBLE TO ANYONE SEEKING TO REMOVE PENETRATING ITEMS OR FIRESTOPPING.	BENJAMIN J.
			SCHLUP
		QUIREMENTS (NFPA-13) NEER, DESIGN, BID AND INSTALL A COMPLETE AND OPERATIONAL FIRE PROTECTION	ATE OF OTHE
BLE LINK, FULLY			project:
S SPACES NOT	D.	EXPOSED HEADS IN SOLID CEILINGS: SEMI-RECESSED TYPE WITH SHALLOW FRICTION ADJUSTABLE ESCUTCHEON WITH SATIN CHROME-PLATED FINISH.	Tenant Finish
BLE LINK, FULLY BUILDING SPACES NCE CANOPIES AND	E.	EXPOSED HEADS IN FINISHED METAL CEILING AREAS: SEMI-RECESSED TYPE WITH SATIN BRASS-PLATED ESCUTCHEON CUP, OF COLOR MATCH METAL CEILING.	for New
TED EDITIONS OF	F.	CONCEALED HEADS AND THOSE AREAS WITHOUT CEILINGS: UPRIGHT OR PENDANT TYPE WITH ROUGH BRASS FINISH.	Brighton
			I Recoverv I
GODE, AND ANY AS WELL AS	G.	SPRINKLER HEADS IN ALL AREAS SHALL OPEN AT 160°-165°F, EXCEPT THAT HEADS IN BAKERY, DELI, ELECTRICAL TRANSFORMER ROOMS, AND PHONE/EMS ROOMS SHALL BE RATED AT 212°F.	Recovery Campus
S CODE, AND ANY AS WELL AS ONS TO THE TION OF NG JURISDICTION	G. H.	HEADS IN BAKERY, DELI, ELECTRICAL TRANSFORMER ROOMS, AND	Campus 4905, 4911, 4915,
G CODE, AND ANY AS WELL AS ONS TO THE TION OF NG JURISDICTION PROVAL/PLANCHECK		HEADS IN BAKERY, DELI, ELECTRICAL TRANSFORMER ROOMS, AND PHONE/EMS ROOMS SHALL BE RATED AT 212°F. HEADS IN FREEZER/COOLER BOXES SHALL BE DRY PENDANT TYPE, AND	Campus 4905, 4911, 4915, 4925, 4931, & 4953 South 900 East
S CODE, AND ANY AS WELL AS ONS TO THE TION OF NG JURISDICTION PROVAL/PLANCHECK	H.	HEADS IN BAKERY, DELI, ELECTRICAL TRANSFORMER ROOMS, AND PHONE/EMS ROOMS SHALL BE RATED AT 212°F. HEADS IN FREEZER/COOLER BOXES SHALL BE DRY PENDANT TYPE, AND SHALL BE OF COLOR TO MATCH CEILING. PENDANT HEADS ON DRY SPRINKLER SYSTEM SHALL BE DRY PENDANT TYPE AND SHALL BE OF COLOR TO MATCH CEILING. LEGEND:	Campus 4905, 4911, 4915, 4925, 4931, & 4953
CODE, AND ANY AS WELL AS ONS TO THE TION OF NG JURISDICTION PROVAL/PLANCHECK A: ROUP 1 IN THE NFPA 13.	Н. I.	HEADS IN BAKERY, DELI, ELECTRICAL TRANSFORMER ROOMS, AND PHONE/EMS ROOMS SHALL BE RATED AT 212°F. HEADS IN FREEZER/COOLER BOXES SHALL BE DRY PENDANT TYPE, AND SHALL BE OF COLOR TO MATCH CEILING. PENDANT HEADS ON DRY SPRINKLER SYSTEM SHALL BE DRY PENDANT TYPE AND SHALL BE OF COLOR TO MATCH CEILING.	Campus 4905, 4911, 4915, 4925, 4931, & 4953 South 900 East Salt Lake County, Utah
CODE, AND ANY AS WELL AS INS TO THE TION OF IG JURISDICTION ROVAL/PLANCHECK NEROUP 1 IN THE NFPA 13. TION	Н. І. Ј.	HEADS IN BAKERY, DELI, ELECTRICAL TRANSFORMER ROOMS, AND PHONE/EMS ROOMS SHALL BE RATED AT 212°F. HEADS IN FREEZER/COOLER BOXES SHALL BE DRY PENDANT TYPE, AND SHALL BE OF COLOR TO MATCH CEILING. PENDANT HEADS ON DRY SPRINKLER SYSTEM SHALL BE DRY PENDANT TYPE AND SHALL BE OF COLOR TO MATCH CEILING. LEGEND: 	Campus 4905, 4911, 4915, 4925, 4931, & 4953 South 900 East Salt Lake County, Utah date February 24, 2017
CODE, AND ANY AS WELL AS ONS TO THE TION OF NG JURISDICTION PROVAL/PLANCHECK A: ROUP 1 IN THE NFPA 13. TION OVED BY THE ILDING ELEMENTS. SPRINKLER HEAD	Н. І. Ј.	HEADS IN BAKERY, DELI, ELECTRICAL TRANSFORMER ROOMS, AND PHONE/EMS ROOMS SHALL BE RATED AT 212°F. HEADS IN FREEZER/COOLER BOXES SHALL BE DRY PENDANT TYPE, AND SHALL BE OF COLOR TO MATCH CEILING. PENDANT HEADS ON DRY SPRINKLER SYSTEM SHALL BE DRY PENDANT TYPE AND SHALL BE OF COLOR TO MATCH CEILING. LEGEND: ————————————————————————————————————	Campus 4905, 4911, 4915, 4925, 4931, & 4953 South 900 East Salt Lake County, Utah date February 24, 2017 revisions
CODE, AND ANY AS WELL AS ONS TO THE TION OF NG JURISDICTION PROVAL/PLANCHECK A: ROUP 1 IN THE NFPA 13. TION OVED BY THE ILDING ELEMENTS. SPRINKLER HEAD DETAILS MAY OR DING.	Н. І. Ј.	HEADS IN BAKERY, DELI, ELECTRICAL TRANSFORMER ROOMS, AND PHONE/EMS ROOMS SHALL BE RATED AT 212°F. HEADS IN FREEZER/COOLER BOXES SHALL BE DRY PENDANT TYPE, AND SHALL BE OF COLOR TO MATCH CEILING. PENDANT HEADS ON DRY SPRINKLER SYSTEM SHALL BE DRY PENDANT TYPE AND SHALL BE OF COLOR TO MATCH CEILING. LEGEND: 	Campus 4905, 4911, 4915, 4925, 4931, & 4953 South 900 East Salt Lake County, Utah date February 24, 2017 revisions PERMIT SET-December 28, 2016 ADDENDUM #1-January 04, 2017 3 ADDENDUM #3-January 11, 2017
AS WELL AS ONS TO THE TION OF NG JURISDICTION PROVAL/PLANCHECK A: ROUP 1 IN THE NFPA 13. TION OVED BY THE ILDING ELEMENTS. SPRINKLER HEAD DETAILS MAY OR DING. DRAWINGS AND CAPACITIES AND L BE ADHERED TO. IN ALL SPRINKLER	Н. І. Ј. 17.	HEADS IN BAKERY, DELI, ELECTRICAL TRANSFORMER ROOMS, AND PHONE/EMS ROOMS SHALL BE RATED AT 212°F. HEADS IN FREEZER/COOLER BOXES SHALL BE DRY PENDANT TYPE, AND SHALL BE OF COLOR TO MATCH CEILING. PENDANT HEADS ON DRY SPRINKLER SYSTEM SHALL BE DRY PENDANT TYPE AND SHALL BE OF COLOR TO MATCH CEILING. LEGEND:	Campus 4905, 4911, 4915, 4925, 4931, & 4953 South 900 East Salt Lake County, Utah date February 24, 2017 revisions PERMIT SET-December 28, 2016 ADDENDUM #1-January 04, 2017
CODE, AND ANY AS WELL AS NS TO THE TION OF IG JURISDICTION ROVAL/PLANCHECK ROUP 1 IN THE NFPA 13. TION OVED BY THE LDING ELEMENTS. SPRINKLER HEAD . DETAILS MAY OR DING. DRAWINGS AND CAPACITIES AND L BE ADHERED TO. IN ALL SPRINKLER THE RISER CHECK ESSARY TO VENT	н. I. J. 17. 18.	HEADS IN BAKERY, DELI, ELECTRICAL TRANSFORMER ROOMS, AND PHONE/EMS ROOMS SHALL BE RATED AT 212°F. HEADS IN FREEZER/COOLER BOXES SHALL BE DRY PENDANT TYPE, AND SHALL BE OF COLOR TO MATCH CEILING. PENDANT HEADS ON DRY SPRINKLER SYSTEM SHALL BE DRY PENDANT TYPE AND SHALL BE OF COLOR TO MATCH CEILING. LEGEND: ————————————————————————————————————	Campus 4905, 4911, 4915, 4925, 4931, & 4953 South 900 East Salt Lake County, Utah date revisions PERMIT SET-December 28, 2016 ADDENDUM #1-January 04, 2017 ADDENDUM #3-January 11, 2017 ADDENDUM #3-January 17, 2017 ADDENDUM #5-January 20, 2017 ADDENDUM #7-February 24, 2017 data project no: drawn by:
AS WELL AS NS TO THE TION OF IG JURISDICTION ROVAL/PLANCHECK ROUP 1 IN THE NFPA 13. TION DVED BY THE LDING ELEMENTS. SPRINKLER HEAD .DETAILS MAY OR DING. .DRAWINGS AND CAPACITIES AND L BE ADHERED TO. N ALL SPRINKLER THE RISER CHECK ESSARY TO VENT E SEPARABLE	н. J. 17. 18. 20. 21.	HEADS IN BAKERY, DELI, ELECTRICAL TRANSFORMER ROOMS, AND PHONE/EMS ROOMS SHALL BE RATED AT 212°F. HEADS IN FREEZER/COOLER BOXES SHALL BE DRY PENDANT TYPE, AND SHALL BE OF COLOR TO MATCH CEILING. PENDANT HEADS ON DRY SPRINKLER SYSTEM SHALL BE DRY PENDANT TYPE AND SHALL BE OF COLOR TO MATCH CEILING. LEGEND:	Campus 4905, 4911, 4915, 4925, 4931, & 4953 South 900 East Salt Lake County, Utah date rebruary 24, 2017 revisions PERMIT SET-December 28, 2016 ADDENDUM #1-January 04, 2017 ADDENDUM #3-January 11, 2017 4 ADDENDUM #3-January 17, 2017 5 ADDENDUM #5-January 20, 2017 7 ADDENDUM #7-February 24, 2017 data project no: drawn by: checked by:
AS WELL AS NS TO THE TION OF IG JURISDICTION ROVAL/PLANCHECK ROUP 1 IN THE NFPA 13. TION DVED BY THE LDING ELEMENTS. SPRINKLER HEAD DETAILS MAY OR DING. DRAWINGS AND CAPACITIES AND L BE ADHERED TO. N ALL SPRINKLER THE RISER CHECK ESSARY TO VENT E SEPARABLE FLUSH THE PIPING CTOR SHALL TALLATION.	н. J. 17. 18. 20. 21.	HEADS IN BAKERY, DELI, ELECTRICAL TRANSFORMER ROOMS, AND PHONE/EMS ROOMS SHALL BE RATED AT 212°F. HEADS IN FREEZER/COOLER BOXES SHALL BE DRY PENDANT TYPE, AND SHALL BE OF COLOR TO MATCH CEILING. PENDANT HEADS ON DRY SPRINKLER SYSTEM SHALL BE DRY PENDANT TYPE AND SHALL BE OF COLOR TO MATCH CEILING. LEGEND:	Campus 4905, 4911, 4915, 4925, 4931, & 4953 South 900 East Salt Lake County, Utah date revisions PERMIT SET-December 28, 2016 ADDENDUM #1-January 04, 2017 ADDENDUM #3-January 11, 2017 ADDENDUM #3-January 17, 2017 ADDENDUM #5-January 20, 2017 ADDENDUM #7-February 24, 2017 data project no: drawn by:
AS WELL AS NS TO THE TION OF IG JURISDICTION ROVAL/PLANCHECK ROUP 1 IN THE NFPA 13. TION DVED BY THE LDING ELEMENTS. SPRINKLER HEAD DETAILS MAY OR DING. DRAWINGS AND CAPACITIES AND L BE ADHERED TO. N ALL SPRINKLER THE RISER CHECK ESSARY TO VENT E SEPARABLE FLUSH THE PIPING CTOR SHALL TALLATION. IG INFORMATION	н. J. 17. 18. 20. 21. 22.	HEADS IN BAKERY, DELI, ELECTRICAL TRANSFORMER ROOMS, AND PHONE/EMS ROOMS SHALL BE RATED AT 212°F. HEADS IN FREEZER/COOLER BOXES SHALL BE DRY PENDANT TYPE, AND SHALL BE OF COLOR TO MATCH CEILING. PENDANT HEADS ON DRY SPRINKLER SYSTEM SHALL BE DRY PENDANT TYPE AND SHALL BE OF COLOR TO MATCH CEILING. LEGEND: ————————————————————————————————————	Campus 4905, 4911, 4915, 4925, 4931, & 4953 South 900 East Salt Lake County, Utah date February 24, 2017 revisions PERMIT SET-December 28, 2016 ADDENDUM #1-January 04, 2017 ADDENDUM #3-January 11, 2017 ADDENDUM #3-January 17, 2017 ADDENDUM #5-January 20, 2017 ADDENDUM #5-January 20, 2017 ADDENDUM #7-February 24, 2017 data project no: drawn by: checked by: title PLUMBING EQUIPMENT SPECIFICATIONS
CODE, AND ANY AS WELL AS ONS TO THE TION OF NG JURISDICTION PROVAL/PLANCHECK A: GROUP 1 IN THE NFPA 13. TION OVED BY THE ILDING ELEMENTS. SPRINKLER HEAD DETAILS MAY OR DING. DRAWINGS AND CAPACITIES AND L BE ADHERED TO. IN ALL SPRINKLER THE RISER CHECK CESSARY TO VENT E SEPARABLE FLUSH THE PIPING ACTOR SHALL STALLATION. NG INFORMATION JSE SPACES,	н. J. 17. 18. 20. 21. 22. 23. 23.	HEADS IN BAKERY, DELI, ELECTRICAL TRANSFORMER ROOMS, AND PHONE/EMS ROOMS SHALL BE RATED AT 212°F. HEADS IN FREEZER/COOLER BOXES SHALL BE DRY PENDANT TYPE, AND SHALL BE OF COLOR TO MATCH CEILING. PENDANT HEADS ON DRY SPRINKLER SYSTEM SHALL BE DRY PENDANT TYPE AND SHALL BE OF COLOR TO MATCH CEILING. LEGEND: O UPRIGHT O RY PENDENT RECORD DESIGN DRAWINGS SHOWING ALL EQUIPMENT, COMPONENTS, PIPING AND CONTROLS SHALL BE ON MYLAR AND BE DRAWIN IN AUTOCAD. DISK COPIES SHALL BE ON MYLAR AND BE DRAWIN IN AUTOCAD. DISK COPIES SHALL BE PROVIDED TO THE OWNER AND BE DRAWIN IN AUTOCAD. DISK COPIES SHALL BE PROVIDED TO THE OWNER AND BE DRAWIN IN AUTOCAD. DISK COPIES SHALL BE PROVIDED TO THE OWNER AND BE DRAWIN IN AUTOCAD. DISK COPIES SHALL BE PROVIDED TO THE OWNER AND ARCHITECT/ENGINEER. DESIGN FOR SEISMIC DESIGN CATEGORY AND SEISMIC USE GROUP, IN ACCORDANCE WITH THE LATEST ADOPTED EDITIONS OF THE IBC, UBC, ASHRAE, AND SMACNA. CONTRACTOR SHALL LOCATE P.I.V., RISERS, INCOMING SERVICE, ZONE VALVES AND FEED AND BRANCH MAINS IN LOCATIONS SHOWN ON THESE DRAWINGS. THE WORKING DRAWINGS ARE DIAGRAMMATIC. BECAUSE OF THE SMALL SCALE OF THE DRAWINGS, THEY DO NOT SHOW EVERY OFFSET, BEND OR ELBOW WITH THE ARCHITECTION ITEMS SHALL BE CHECKED AND COORDINATED WITH THE ARCHITECTURAL, MECHANICAL, STRUCTURAL, AND ELECTRICAL, AND ARCHICETURAL, MECHANICAL, STRUCTURAL, AND ELECTRICAL, AND ARCHITECTURAL REQUIREMENTS AND TRADES. RESOLVE POTENTIAL CONFLICTS BEFORE PROCEEDION WITH INSTALLATION. IN ALL CASES, GRADED PIPE RUNS TAKE FIRST PRIORITY ON RUTING, GENERALLY, DUCTWORK TAKES SECOND PRIORITY. UPON COMPLETION OF THE WORK, REMOVE ALL SURPLUS MATERIALS AND RUBBISH. MAKE ALL REQUIRED PATCHING AND REPAIRS OF OTHER TRADES' WORK DAMAGED BY THIS CONTRACTOR, AND LEAVE THE PREMISES IN A CLEAN, ORDERLY CONDITION. THE CONTRACTOR SHALL GUARANTEE THE ENTIRE FIRE PROTECTION SYSTEM FOR A PERIOD OF ONE YEAR FROM THE DATE OF SUBSTANTIAL COMPLETION. ALL ALLOWABLE SPRINKLER SYSTEM COMPONENTS SHALLA BE PRIMED AND PAINTED RED, SYSTEM COMPONENTS WHICH MAY	Campus 4905, 4911, 4915, 4925, 4931, & 4953 South 900 East Salt Lake County, Utah date February 24, 2017 revisions PERMIT SET-December 28, 2016 ADDENDUM #1-January 04, 2017 ADDENDUM #3-January 11, 2017 ADDENDUM #4-January 17, 2017 ADDENDUM #5-January 20, 2017 ADDENDUM #5-January 20, 2017 ADDENDUM #7-February 24, 2017 data project no: drawn by: checked by: title PLUMBING EQUIPMENT
AS WELL AS ONS TO THE TION OF NG JURISDICTION PROVAL/PLANCHECK A: BROUP 1 IN THE INFPA 13. TION COVED BY THE ILDING ELEMENTS. SPRINKLER HEAD L DETAILS MAY OR DING. L DRAWINGS AND CAPACITIES AND L BE ADHERED TO. IN ALL SPRINKLER THE RISER CHECK CESSARY TO VENT TE SEPARABLE FLUSH THE PIPING ACTOR SHALL STALLATION. NG INFORMATION USE SPACES, SHALL BE QUICK IONS SHALL BE COVED FOR REQUIRED. ECE TYPE	н. J. 17. 18. 19. 20. 21. 22. 23.	HEADS IN BAKERY, DELI, ELECTRICAL TRANSFORMER ROOMS, AND PHONE/EMS ROOMS SHALL BE RATED AT 212°F. HEADS IN FREEZER/COOLER BOXES SHALL BE DRY PENDANT TYPE, AND SHALL BE OF COLOR TO MATCH CEILING. PENDANT HEADS ON DRY SPRINKLER SYSTEM SHALL BE DRY PENDANT TYPE AND SHALL BE OF COLOR TO MATCH CEILING. LEGEND: O UPRIGHT O RY PENDENT RECORD DESIGN DRAWINGS SHOWING ALL EQUIPMENT, COMPONENTS, PIPING AND CONTROLS SHALL BE ON MYLAR AND BE DRAWIN IN AUTOCAD. DISK COPIES SHALL BE ON MYLAR AND BE DRAWIN IN AUTOCAD. DISK COPIES SHALL BE PROVIDED TO THE OWNER AND BE DRAWIN IN AUTOCAD. DISK COPIES SHALL BE PROVIDED TO THE OWNER AND BE DRAWIN IN AUTOCAD. DISK COPIES SHALL BE PROVIDED TO THE OWNER AND BE DRAWIN IN AUTOCAD. DISK COPIES SHALL BE PROVIDED TO THE OWNER AND ARCHITECT/ENGINEER. DESIGN FOR SEISMIC DESIGN CATEGORY AND SEISMIC USE GROUP, IN ACCORDANCE WITH THE LATEST ADOPTED EDITIONS OF THE IBC, UBC, ASHRAE, AND SMACNA. CONTRACTOR SHALL LOCATE P.I.V., RISERS, INCOMING SERVICE, ZONE VALVES AND FEED AND BRANCH MAINS IN LOCATIONS SHOWN ON THESE DRAWINGS. THE WORKING DRAWINGS ARE DIAGRAMMATIC. BECAUSE OF THE SMALL SCALE OF THE DRAWINGS, THEY DO NOT SHOW EVERY OFFSET, BEND OR ELBOW WITH THE ARCHITECTION ITEMS SHALL BE CHECKED AND COORDINATED WITH THE ARCHITECTURAL, MECHANICAL, STRUCTURAL, AND ELECTRICAL, AND ARCHICETURAL, MECHANICAL, STRUCTURAL, AND ELECTRICAL, AND ARCHITECTURAL REQUIREMENTS AND TRADES. RESOLVE POTENTIAL CONFLICTS BEFORE PROCEEDION WITH INSTALLATION. IN ALL CASES, GRADED PIPE RUNS TAKE FIRST PRIORITY ON RUTING, GENERALLY, DUCTWORK TAKES SECOND PRIORITY. UPON COMPLETION OF THE WORK, REMOVE ALL SURPLUS MATERIALS AND RUBBISH. MAKE ALL REQUIRED PATCHING AND REPAIRS OF OTHER TRADES' WORK DAMAGED BY THIS CONTRACTOR, AND LEAVE THE PREMISES IN A CLEAN, ORDERLY CONDITION. THE CONTRACTOR SHALL GUARANTEE THE ENTIRE FIRE PROTECTION SYSTEM FOR A PERIOD OF ONE YEAR FROM THE DATE OF SUBSTANTIAL COMPLETION. ALL ALLOWABLE SPRINKLER SYSTEM COMPONENTS SHALLA BE PRIMED AND PAINTED RED, SYSTEM COMPONENTS WHICH MAY	Campus 4905, 4911, 4915, 4925, 4931, & 4953 South 900 East Salt Lake County, Utah date February 24, 2017 revisions PERMIT SET-December 28, 2016 ADDENDUM #1-January 04, 2017 ADDENDUM #3-January 11, 2017 ADDENDUM #3-January 17, 2017 ADDENDUM #5-January 20, 2017 ADDENDUM #5-January 20, 2017 ADDENDUM #5-January 20, 2017 data project no: drawn by: checked by: title PLUMBING EQUIPMENT SPECIFICATIONS

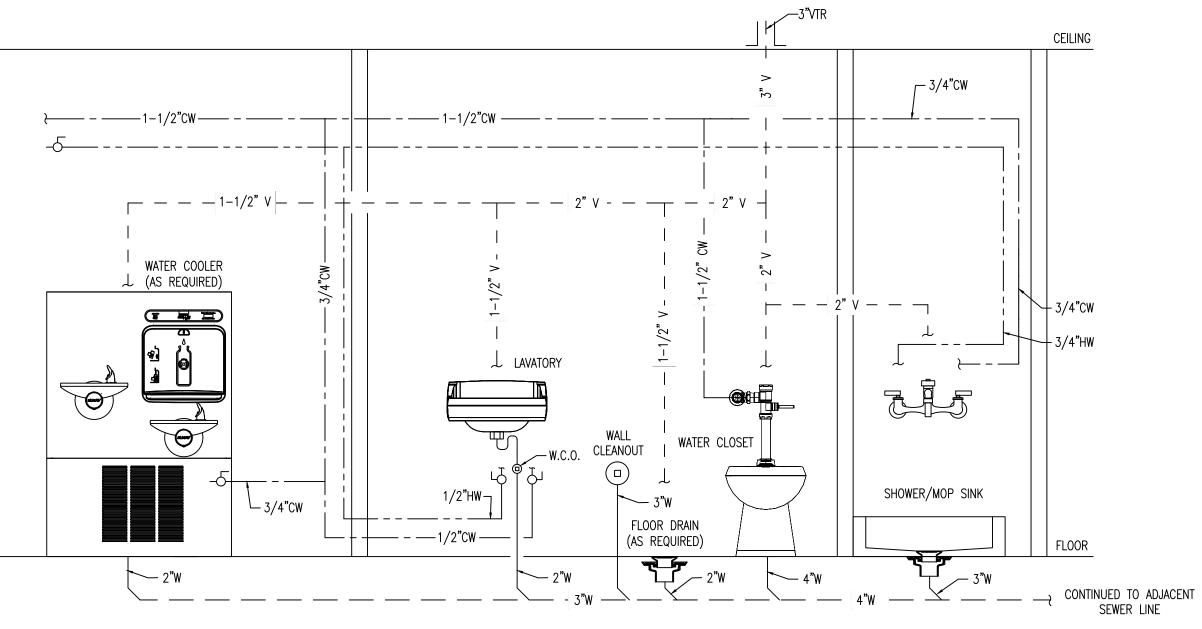





								Donald L. Welch Architect 7533 Sandy Land Lane Midvale, Utah 84047 801.548-6391
SYMBOL	PLU	MANUFACTURER	COLD	НОТ	``		RDINATE MOUNTING HEIGHTS WITH ARCH. PLANS)	
FD-1		AND MODEL NO. SEE P02	WATER	WATER	WASTE	1-1/2"	REFERENCE SHEET P02. FLOOR DRAINS IN FINISHED SPACES TO BE <u>FD-1</u> (2"). ALL WATER ENTRY DRAINS TO BE <u>FD-2</u> (4").	
FD-2	FLOOR DRAINS IESTIC WATER ENTRIES CHECK & BACKFLOW DEVICES	(SPEC SECTION 221316) SEE P02 (SPEC SECTION 221316)	- SEE REMARKS	-	OR 4"	OR 3" -	INSTALL PROVENT TRAP GUARD OR EQUAL IN EACH DRAIN TYPE. REFERENCE SHEET P02. MAKE/MODELS FOR FIRE/WATER ENTRY BACKFLOW PREVENTER AND DOUBLE CHECK DETECTOR ASSEMBLIES INDICATED. 4" FIRE ENTRY LINE WHERE INDICATED. BUILDINGS C & D TO INCORPORATE A 1-1/2" WATER SERVICE. BUILDINGS A, B, E, F TO HAVE 2" DOMESTIC WATER SERVICE. LOCATE FIRE CONTROL PANEL AT EACH FIRE ENTRY. ELECTRICAL: PROVIDE LINE VOLTAGE POWER (115V CIRCUITS) TO FIRE ENTRY FLOW SWITCH & AIR COMPRESSOR	
SH-1	SHOWER (ADA) (FLOOR MOUNTED)	SEE ARCHITECTURAL	1/2"	1/2"	2"	1-1/2"	REFERENCE ARCHITECTURAL SHEET A6.1A. SPECIFICATIONS FOR SHOWER INSERT, DRAIN, SHOWERHEAD, VALVES, & ASSOCIATED ACCESSORIES ARE INDICATED.	THE DESIGNS SHOWN AND DESCRIBED NCLUDING ALL TECHNICAL DRAWINGS, GRAPHIC REPRESENTATION & MODELS
GWH-1	GAS WATER HEATER (FLOOR MOUNTED)	BRADFORD WHITE EF-100T-300E-3N(A)	1-1/2"	1-1/2"	-	-	COMMERCIAL ULTRA HIGH EFFICIENCY GAS WATER HEATER. 92% THERMAL EFFICIENCY. DIRECT SPARK IGNITION. 300 MBH INPUT, 3/4" GAS CONNECTION, 100 GALLON CAPACITY, 335 GPH RECOVERY @ 100°F, DISCHARGE T&P VALVE INTO MOP SINK OR FLOOR DRAIN. PROVIDE 4.4 GALLON EXPANSION TANK (AMTROL EX-30 OR EQUAL). PROVIDE SEISMIC WATER HEATER STRAPS. DIMENSIONS: 77-5/8" H X 28-1/4" DIA 900 LB SHIPPING WEIGHT. PROVIDE 4" (PVC, CPVC, OR ABS) VERTICAL VENTING. TERMINATE THROUGH ROOF WITH CONCENTRIC VENT KIT PER MANUFACTURER'S RECOMMENDATIONS. ELECTRICAL: 115V AC REQUIRED.	THEREOF, ARE PROPRIETARY & CAN N COPIED, DUPLICATED, OR COMMERCIALL EXPLOITED IN WHOLE OR IN PART WITH THE SOLE AND EXPRESS WRITTEN PERMISSION FROM DONALD L. WELCH ARCHITECT THESE DRAWINGS ARE AVAILABLE FOR LIMITED REVIEW AND EVALUATION BY C
GWH-2	GAS WATER HEATER (FLOOR MOUNTED)	BRADFORD WHITE EF-100T-250E-3N(A)	1-1/2"	1-1/2"	-	-	COMMERCIAL ULTRA HIGH EFFICIENCY GAS WATER HEATER. 97% THERMAL EFFICIENCY. DIRECT SPARK IGNITION. 250 MBH INPUT, 3/4" GAS CONNECTION, 100 GALLON CAPACITY, 294 GPH RECOVERY @ 100°F, DISCHARGE T&P VALVE INTO MOP SINK OR FLOOR DRAIN. PROVIDE 4.4 GALLON EXPANSION TANK (AMTROL EX-30 OR EQUAL). PROVIDE SEISMIC WATER HEATER STRAPS. DIMENSIONS: 77-5/8" H X 28-1/4" DIA 900 LB SHIPPING WEIGHT. PROVIDE 4" (PVC, CPVC, OR ABS) VERTICAL VENTING. TERMINATE THROUGH ROOF WITH CONCENTRIC VENT KIT PER MANUFACTURER'S RECOMMENDATIONS. ELECTRICAL: 115V AC REQUIRED.	CONSULTANTS, CONTRACTORS, GOVERN AGENCIES, VENDORS, AND OFFICE PER ONLY IN ACCORDANCE WITH THIS NOTI
GWH-3	GAS WATER HEATER (FLOOR MOUNTED)	BRADFORD WHITE LG2PDV50H603N	3/4"	3/4"	-	-	LIGHT DUTY COMMERCIAL POWER DIRECT VENT GAS WATER HEATER. 60 MBH INPUT, 1/2" GAS CONNECTION, 48 GALLON CAPACITY, 58 GPH RECOVERY @ 100°F, DISCHARGE T&P VALVE INTO MOP SINK OR FLOOR DRAIN. PROVIDE 2.1 GALLON EXPANSION TANK (WATTS PLT-5 OR EQUAL). PROVIDE SEISMIC WATER HEATER STRAPS. DIMENSIONS: 67" H X 22" DIA 205 LB SHIPPING WEIGHT. PROVIDE 3" (PVC, CPVC, OR ABS) VERTICAL VENTING. TERMINATE THROUGH ROOF WITH CONCENTRIC VENT KIT PER MANUFACTURER'S RECOMMENDATIONS. <u>ELECTRICAL:</u> 110 VAC REQUIRED FOR POWER VENTING (3.1 AMPERES)	consultant:
GWH-4	GAS WATER HEATER (FLOOR MOUNTED)	BRADFORD WHITE EF-60T-199E-3N(A)	1-1/2"	1-1/2"	-	-	COMMERCIAL ULTRA HIGH EFFICIENCY GAS WATER HEATER. 92% THERMAL EFFICIENCY. DIRECT SPARK IGNITION. 199 MBH INPUT, 3/4" GAS CONNECTION, 60 GALLON CAPACITY, 223 GPH RECOVERY @ 100°F, DISCHARGE T&P VALVE INTO MOP SINK OR FLOOR DRAIN. PROVIDE 4.4 GALLON EXPANSION TANK (AMTROL EX-30 OR EQUAL). PROVIDE SEISMIC WATER HEATER STRAPS. DIMENSIONS: 57" H X 28-1/4" DIA 570 LB SHIPPING WEIGHT. PROVIDE 3" (PVC, CPVC, OR ABS) VERTICAL VENTING. TERMINATE THROUGH ROOF WITH CONCENTRIC VENT KIT PER MANUFACTURER'S RECOMMENDATIONS. <u>ELECTRICAL:</u> 115V AC REQUIRED.	BENJAMIN J. SCHLUP ATE OF OTAT
HWCP-1	HOT WATER CIRCULATION PUMP	GRUNDFOS UP10-16BN5/TLC	-	1/2"	-	-	RECIRCULATION PUMP WITH MANUAL TIMER TO ALLOW FOR OPERATION DURING BUSINESS HOURS. INTEGRAL CHECK VALVE. ELECTRICAL: 115V PLUG IN TYPE. (6 FT LINE CORD)	project:
HWCP-2	HOT WATER CIRCULATION PUMP	GRUNDFOS UP25-64SF	-	1/2"	-	-	RECIRCULATION PUMP. INTEGRAL CHECK VALVE. 5 GPM @ 15 FT HEAD, INTEGRAL CHECK VALVE. <u>ELECTRICAL</u> : 115V PLUG IN TYPE. (6 FT LINE CORD) 1/12 HP, 1.7 AMPS	
MSB-1	MOP SINK BASIN	FLORESTONE MSR-2424	3/4"	3/4"	3"	1-1/2"	MOLDED MOP RECEPTOR, 24X24, 10" DEPTH, 18 GAUGE SS DRAIN GRID (#430), KOHLER K-8928, SERVICE SINK FAUCET, 3" THREADED THREADED SPOUT FOR HOSE CONNECTION, RUBBER HOSE WITH WALL HOOK. LEVER HANDLES	Tenant Finis
FS-1	FLOOR SINK	ZURN FD2375 (OR APPROVED EQUAL)	-	-	3"	1-1/2"	ENAMELED CAST IRON, ACID RESISTANT, DOME STRAINER, FULL GRATE	Brighton
WM-1	WATER METER (SUB-METERING)	BADGER RECORDALL MODEL M120 & M170 (OR APPROVED EQUAL)	-	1-1/2"		-	LEAD FREE BRONZE ALLOW DISC METER (MATCH BUILDING WATER ENTRY SIZE 1-1/2" OR 2"), COMPLIES WITH AWWA STANDARD C700, 150 PSI MAX OPERATING PRESSURE.	Recovery
WM-2 BFP-1	BACKFLOW PREVENTER	(OR APPROVED EQUAL) WATTS MODEL SD-2 (OR APPROVED EQUAL)	1/2"	2" -	-	-	BACKFLOW PREVENTER FOR CARBONATED BEVERAGE MACHINES. DUAL CHECK DESIGN FOR PROTECTION OF WATER SUPPLY FROM CARBON DIOXIDE GAS AND CARBONATED WATER. ANSI/NSF STD 18 CERTIFIED, ASSE 1032 APPROVED DUAL CHECK VALVE, 316 STAINLESS STEEL BODY. MAX PRESSURE: 200 PSI, MAX TEMP: 110°F. PROVIDE RECOMMENDED STRAINER.	Campus 4905, 4911, 4915,
GD-1	FOOD WASTE DISPOSER	INSINKERATOR EVOLUTION	-	-	1-1/2"	-	ANTI-VIBRATION MOUNT, 34.6 OZ. CAPACITY, 12-1/4" HEIGHT. ELECTRICAL: 120 V, 3/4 HP, 8.1 AMPS	4925, 4931, & 495 South 900 East
KS-1	KITCHEN SINK (ADA) FAUCET:	KOHLER K-3996-4 & KOHLER FORTE K-10445	1/2"	1/2"	1-1/2"	1-1/2"	33X22X6 DUAL BOWL TOP-MOUNT ADA SINK, 4 HOLE, 18 GAUGE SS, 4" FAUCET CENTERS, 18 GAUGE SS, FAUCET: PULL-OUT SPRAY, 1.8 GPM, LEVER HANDLES, (ADA), 7-3/4" SPOUT REACH, 4 HOLES.	Salt Lake Coun Utah
UR-1	URINAL	SLOAN SU-1006			4.4./01	1-1/2"	TOP SPUD WALL HUNG, STANDARD WASHDOWN URINAL, VITREOUS CHINA	
UR-2	(ADA)	ROYAL 181	1		1-1/2"	1-1/2	1.5 GPF MANUAL FLUSHOMETER WITH WATER HAMMER ARRESTOR. 7 VITREOUS CHINA, ELONGATED BOWL, 1-1/2" TOP SPUD, COMMERCIAL TOILET SEAT, & BOLT CAP ACCESSORY	date February 24,
WC-1 WC-2	WATER CLOSET, FLOOR MOUNT (ADA)	SLOAN WETS-2450.1301 & ROYAL 113-1.28	1-1/2"		4"	2"	VITREOUS CHINA, ELONGATED BOWL, 1-1/2" TOP SPUD, COMMERCIAL TOILET SEAT, & BOLT CAP ACCESSORY 1.28 GPF MANUAL FLUSHOMETER. PROVIDE WITH WATER HAMMER ARRESTOR.	revisions
L-1	LAVATORY (ADA) FAUCET:	SLOAN SS-3001 & KOHLER K-16027-4	1/2"	1/2"	1-1/2"	1-1/2"	19.5"X16.5" VITREOUS CHINA UNDERMOUNTED WITH OVERFLOW. SINGLE HOLE BATHROOM FAUCET (ADA) LESS POP-UP TAIL PIECE, 1.2 GPM, 4-3/8" REACH. PROVIDE BDT VARIATION BELOW DECK THERMOSTATIC MIXING VALVE (SET WATER TEMP TO 110°F) PROVIDE UNDERCOUNTER PIPING INSULATION KIT.	PERMIT SET-December 28,
L-2	LAVATORY (ADA) FAUCET:	SLOAN SS-3101 & KOHLER K 16027 4	1/2"	1/2"	2"	1-1/2"	20 3/4"X18 1/4" VITREOUS CHINA WALL MOUNTED LAVATORY, SINGLE HOLE. SINGLE HOLE BATHROOM FAUCET (ADA) LESS POP-UP TAIL PIECE, 1.2 GPM, 4-3/8" REACH. PROVIDE BDT VARIATION BELOW	ADDENDUM #3—January 11, ADDENDUM #4—January 17,
S-1	SINK FAUCET:	KOHLER K-16027-4 KOHLER VAULT K-5286 UNDER-MOUNT	1/2"	1/2"	1-1/2"	1-1/2"	DECK THERMOSTATIC MIXING VALVE (SET WATER TEMP TO 110°F) PROVIDE UNDERCOUNTER PIPING INSULATION KIT. 24"X18-1/4" 16-GAUGE STAINLESS STEEL, SINGLE SQUARED BOWL, 9-INCH DEPTH FAUCET: KOHLER CORALAIS KITCHEN SINK FAUCET MODEL K-15888-K WRISTBLADE LEVER HANDLED FAUCET (ADA), 9"	/5 ADDENDUM #5—January 20, /7 ADDENDUM#7—February 24,
	SINK	KITCHEN SINK KOHLER VAULT					GOOSENECK SWING SPOUT. 1.8 GPM 15"X15" 19-GAUGE STAINLESS STEEL, SINGLE BOWL, 2 FAUCET HOLES, 7-9/16-INCH DEPTH	data
S-2	(ADA) FAUCET:	K-3349-2 TOP MOUNT SINK	1/2"	1/2"	1-1/2"	1-1/2"	FAUCET: KOHLER CORALAIS KITCHEN SINK FAUCET MODEL K-15888-K WRISTBLADE LEVER HANDLED FAUCET (ADA), 9" GOOSENECK SWING SPOUT. 1.8 GPM	project no: drawn by:
DF-1	DRINKING FOUTAIN	ELKAY ECDFPW314C	1/2"	-	2"	1-1/2"	ADA HEIGHT DRINKING FOUNTAIN, WALL MOUNT, FULLY EXPOSED. 304 STAINLESS STEEL WITH SATIN FINISH.	checked by:
NOTES:		EVIEWED BY ARCHITECT PRIC					RS.	title PLUMBING SCHEDULES & DETAILS sheet

P11

BUILDING 'B'

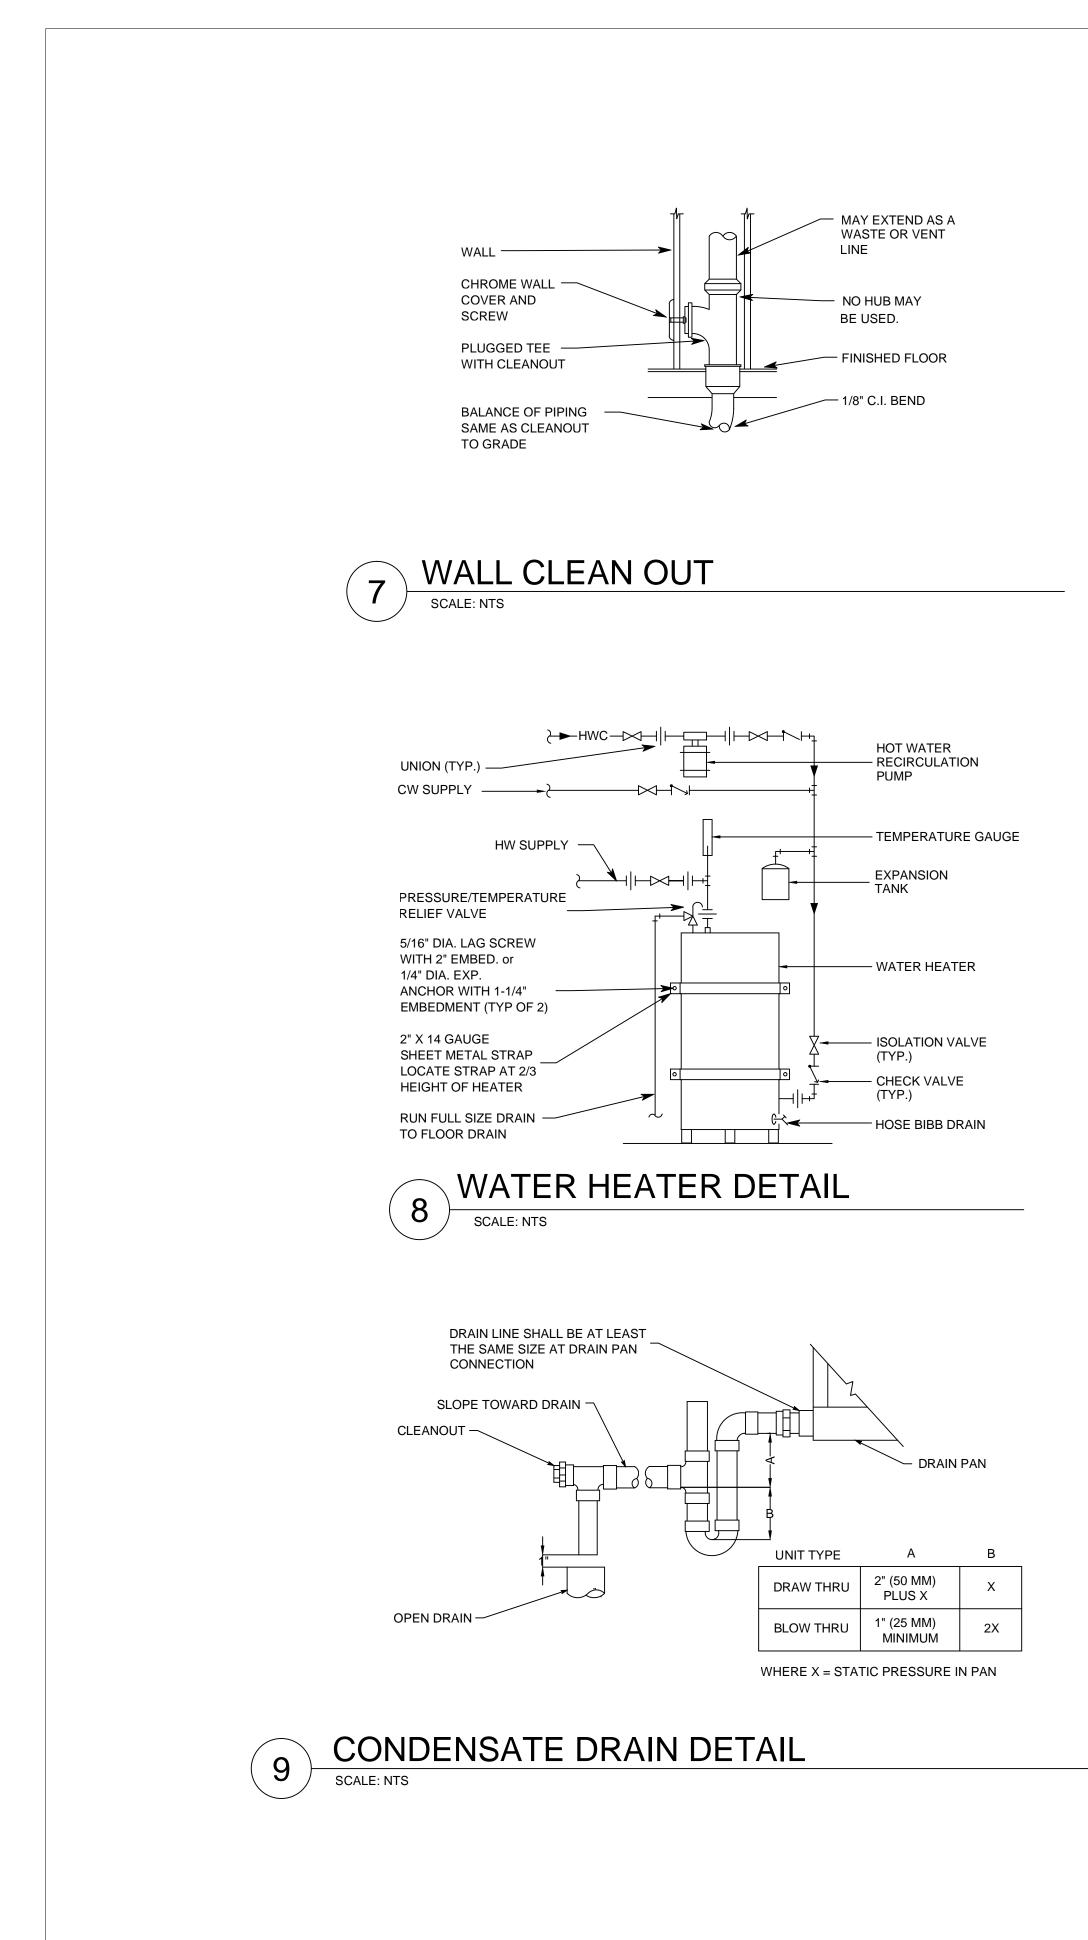


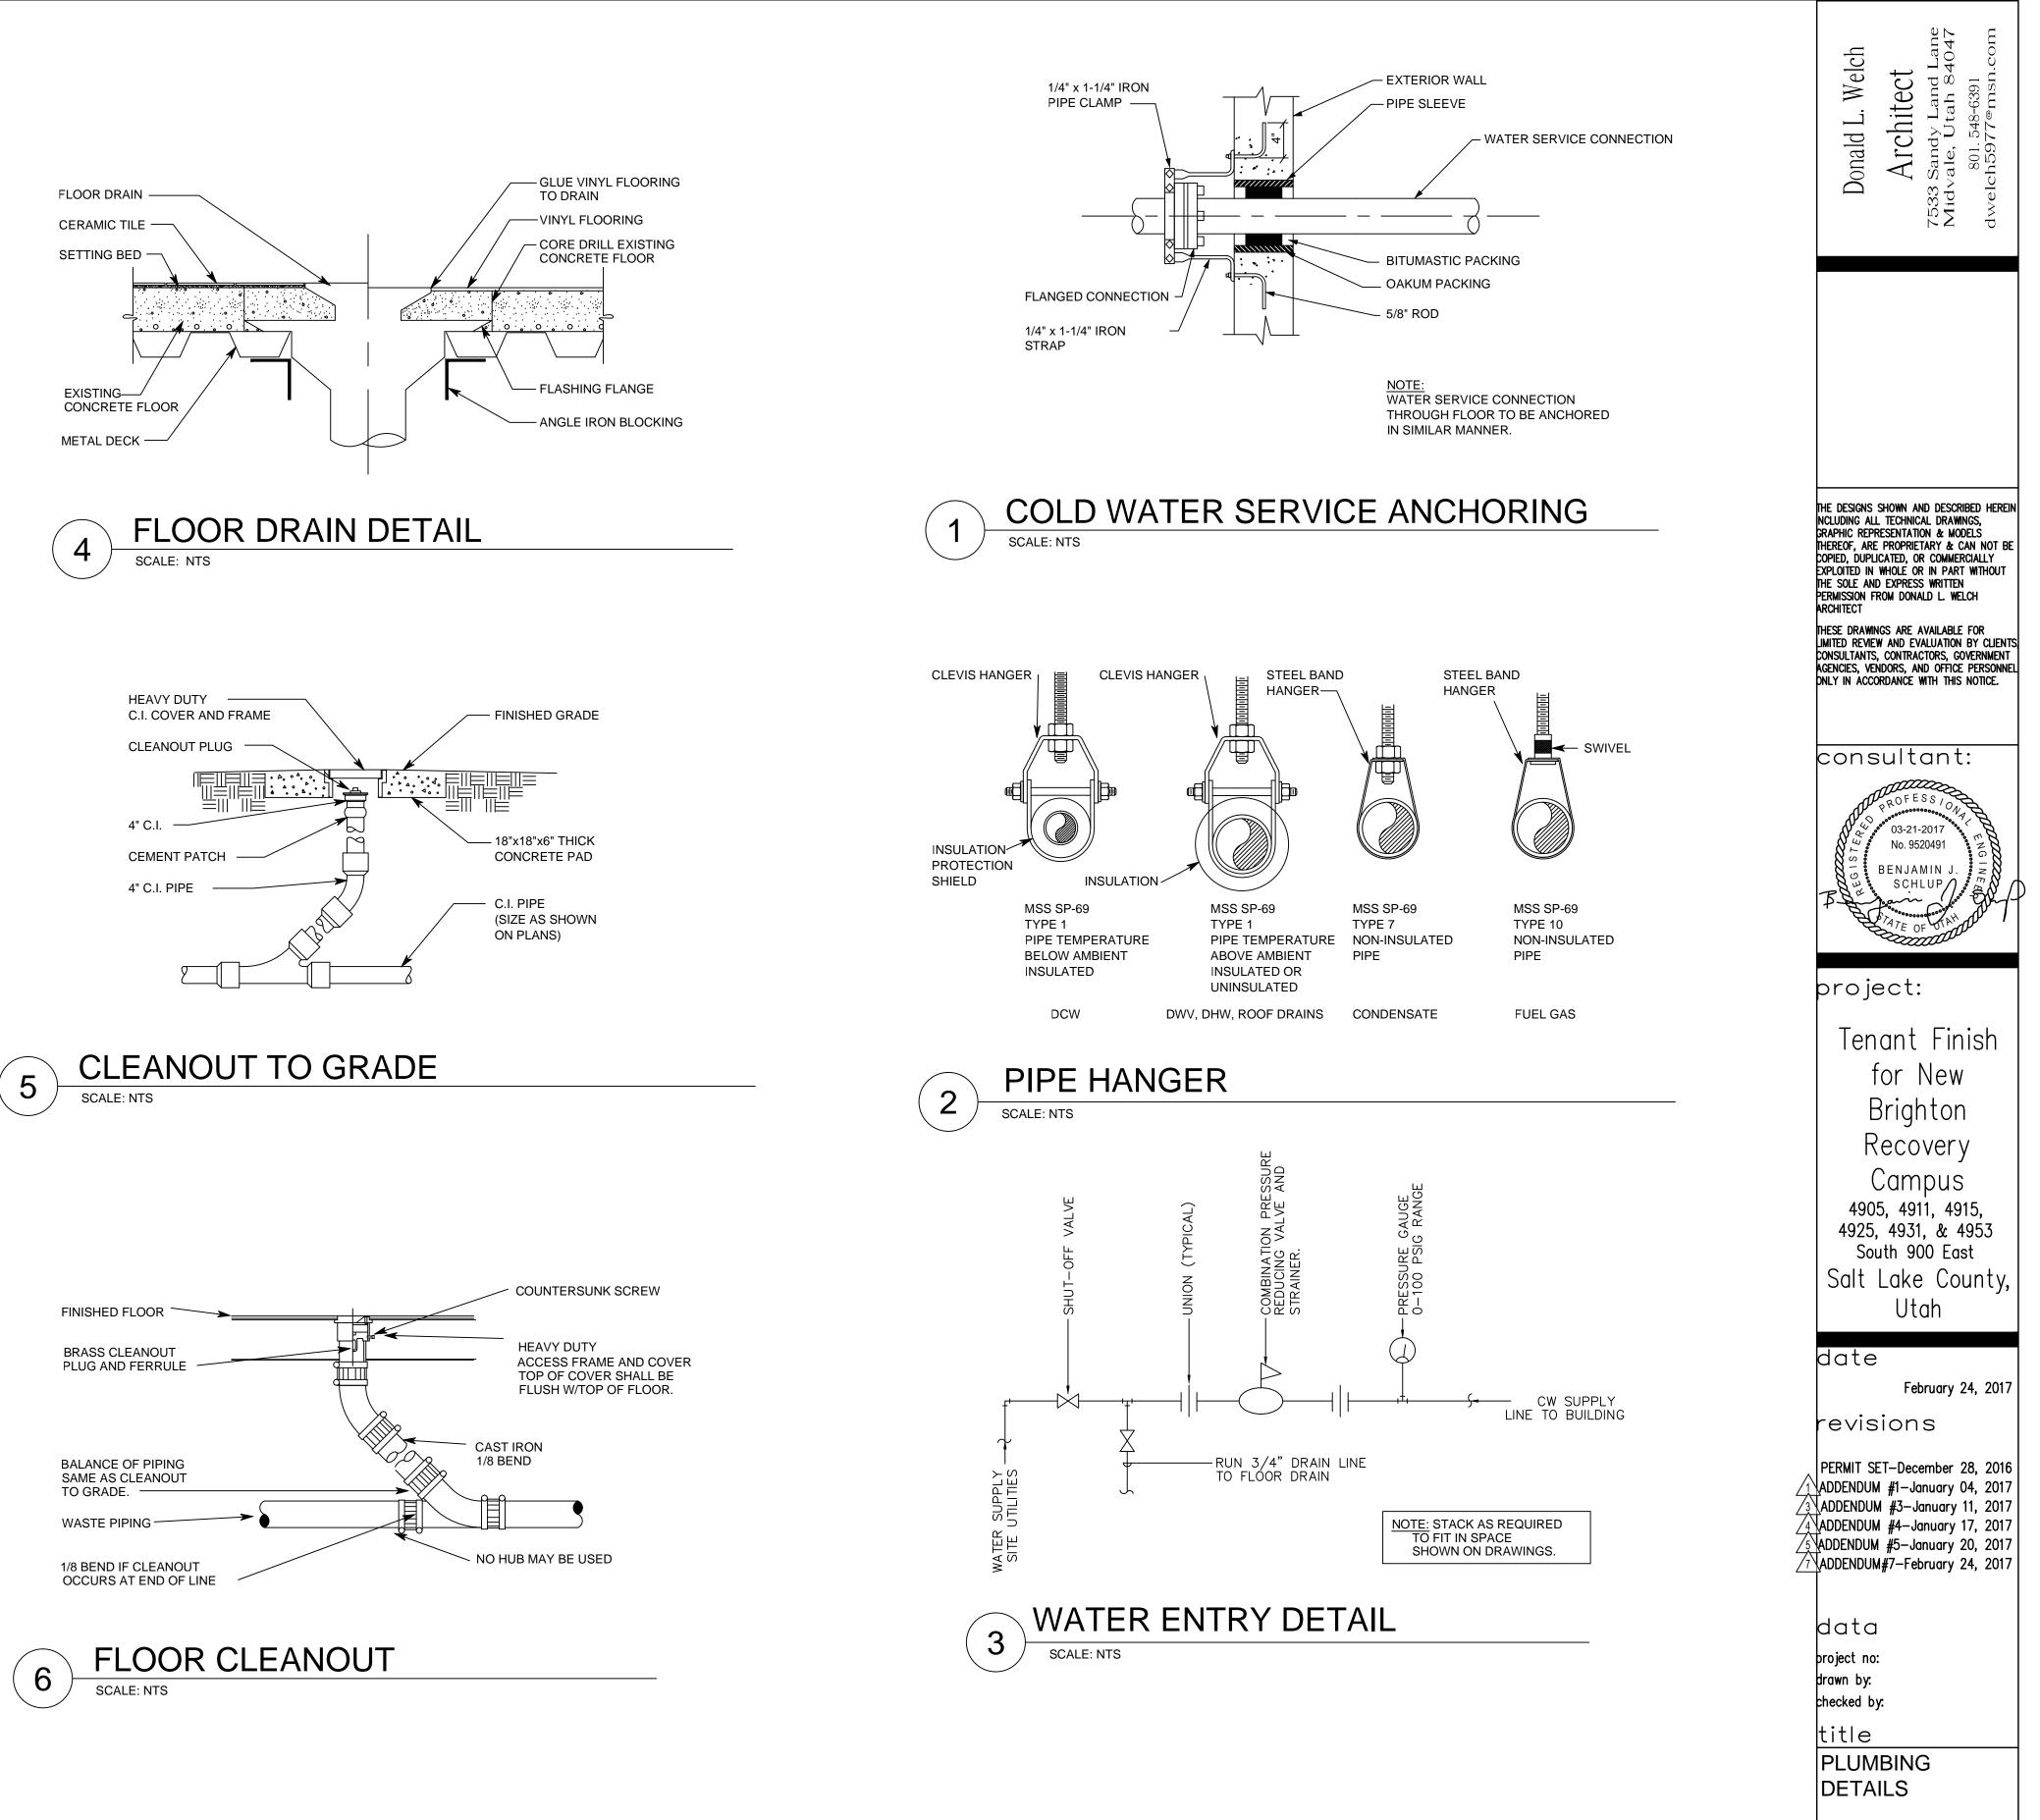



sheet

P12

BUILDING 'B'

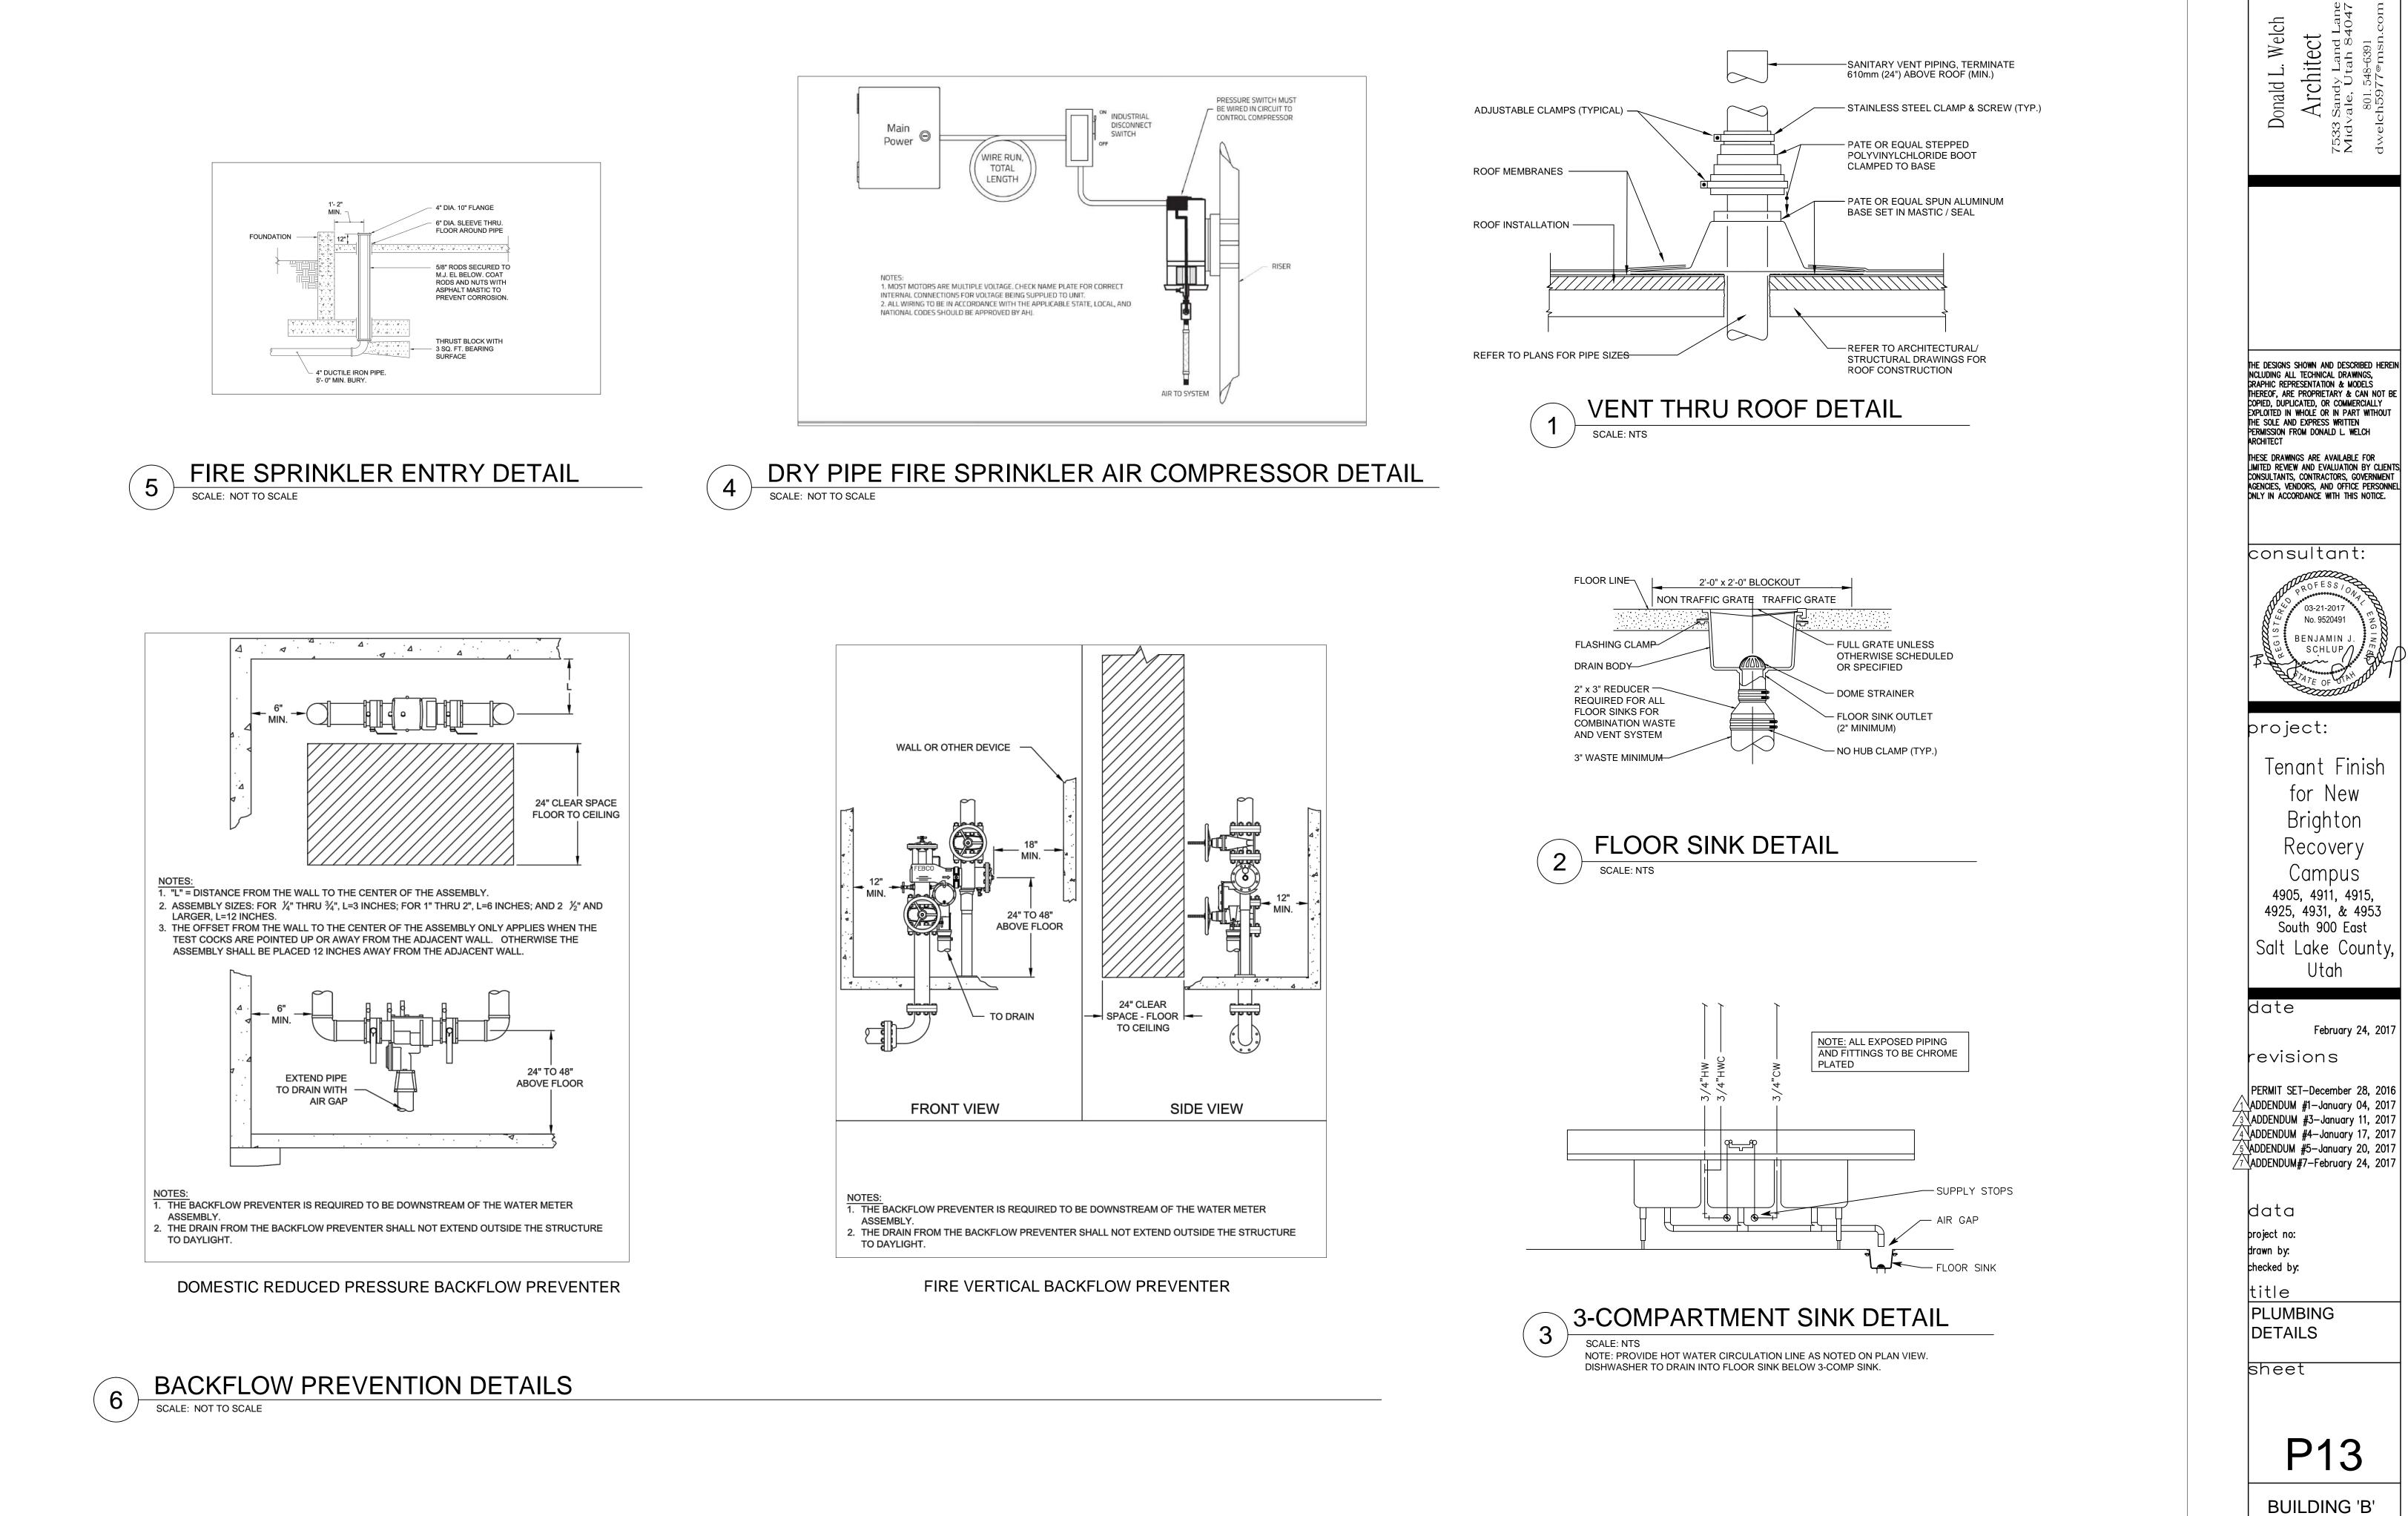

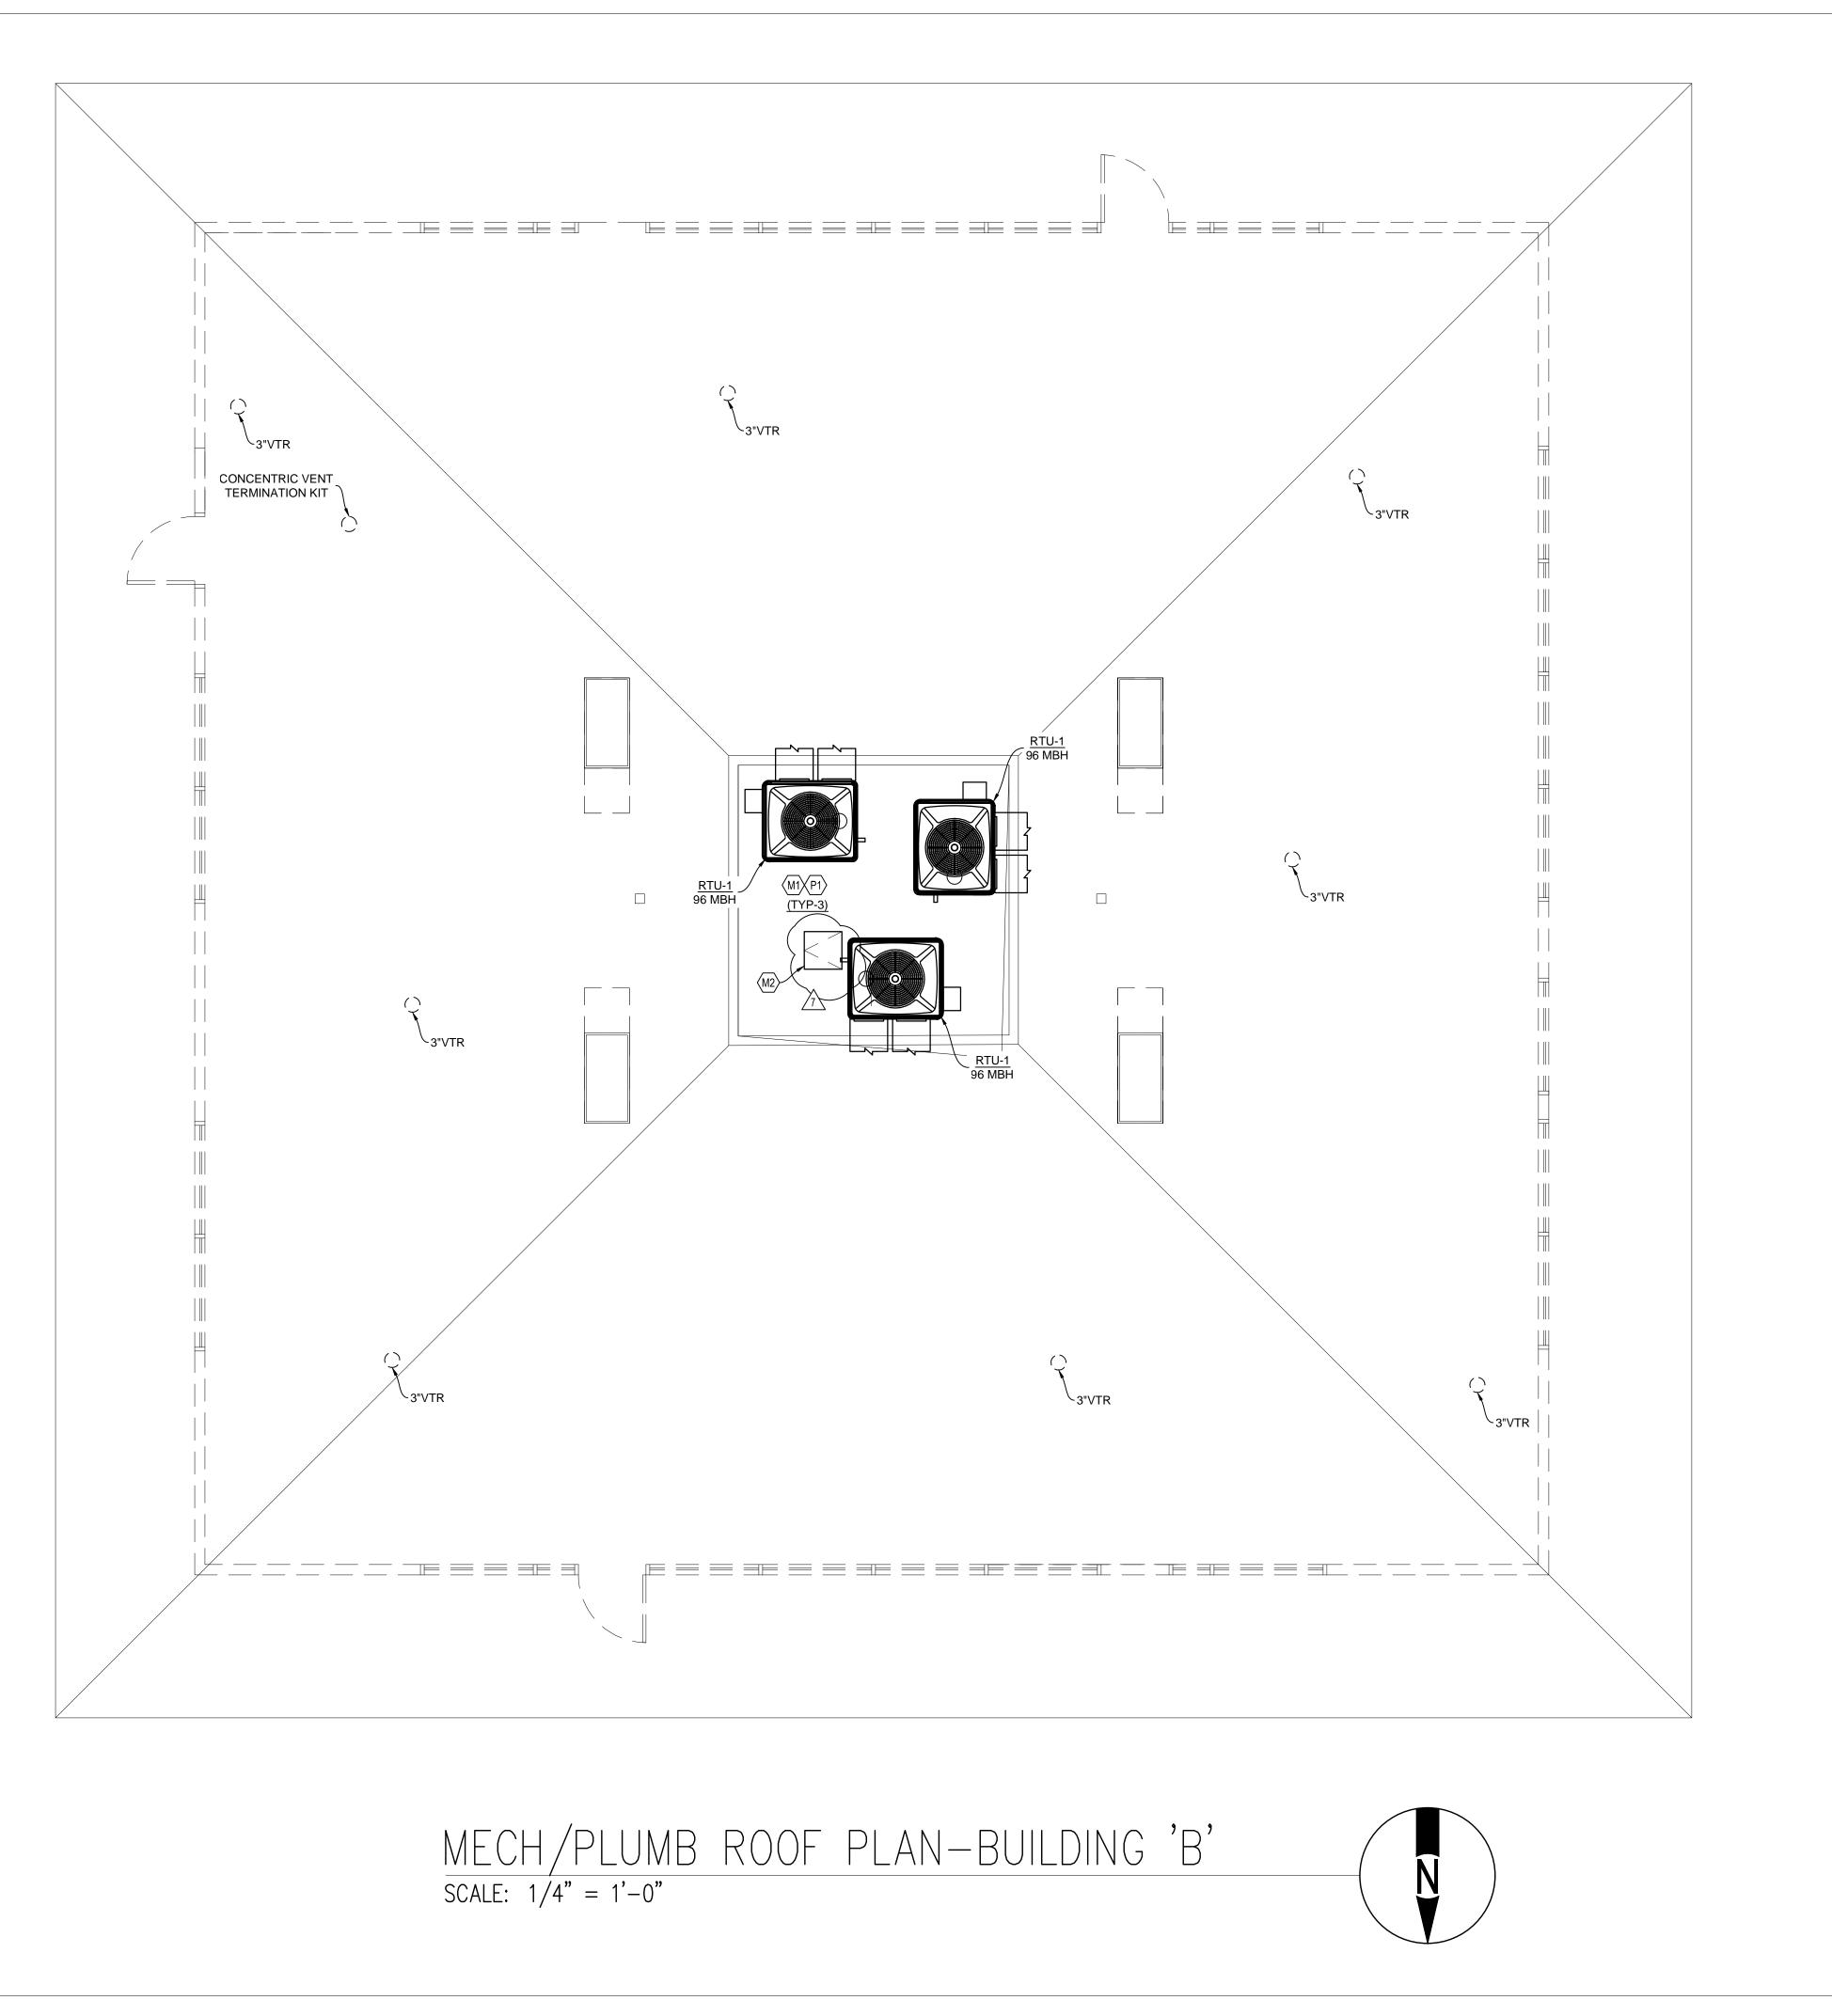

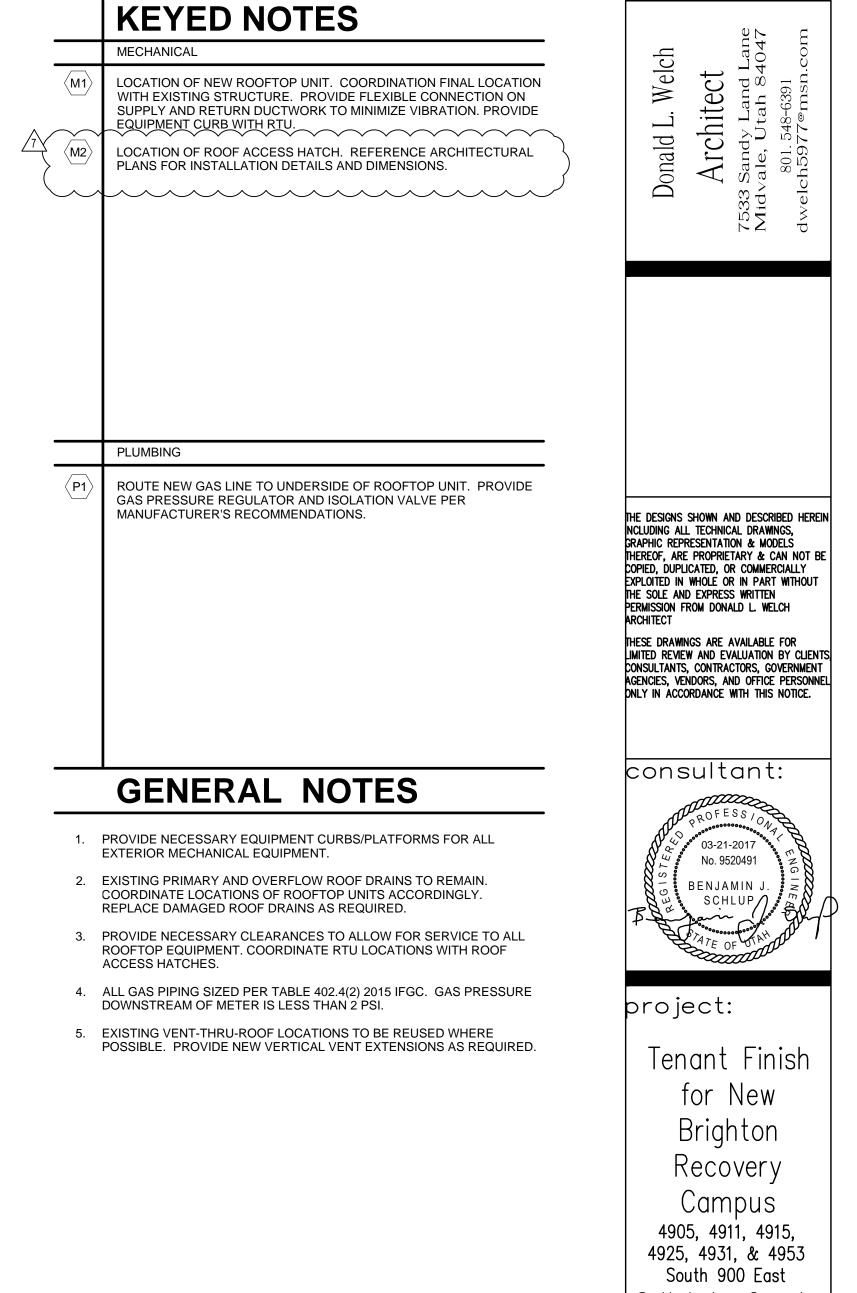

Salt Lake County, Utah date February 24, 2017 revisions


PERMIT SET-December 28, 2016 1 ADDENDUM #1-January 04, 2017 3 ADDENDUM #3-January 11, 2017 4 ADDENDUM #4-January 17, 2017 5 ADDENDUM #5-January 20, 2017 7 ADDENDUM #7-February 24, 2017

data project no: drawn by: checked by:

title MECH/PLUMB ROOF PLAN BUILDING 'B' sheet



BUILDING 'B'

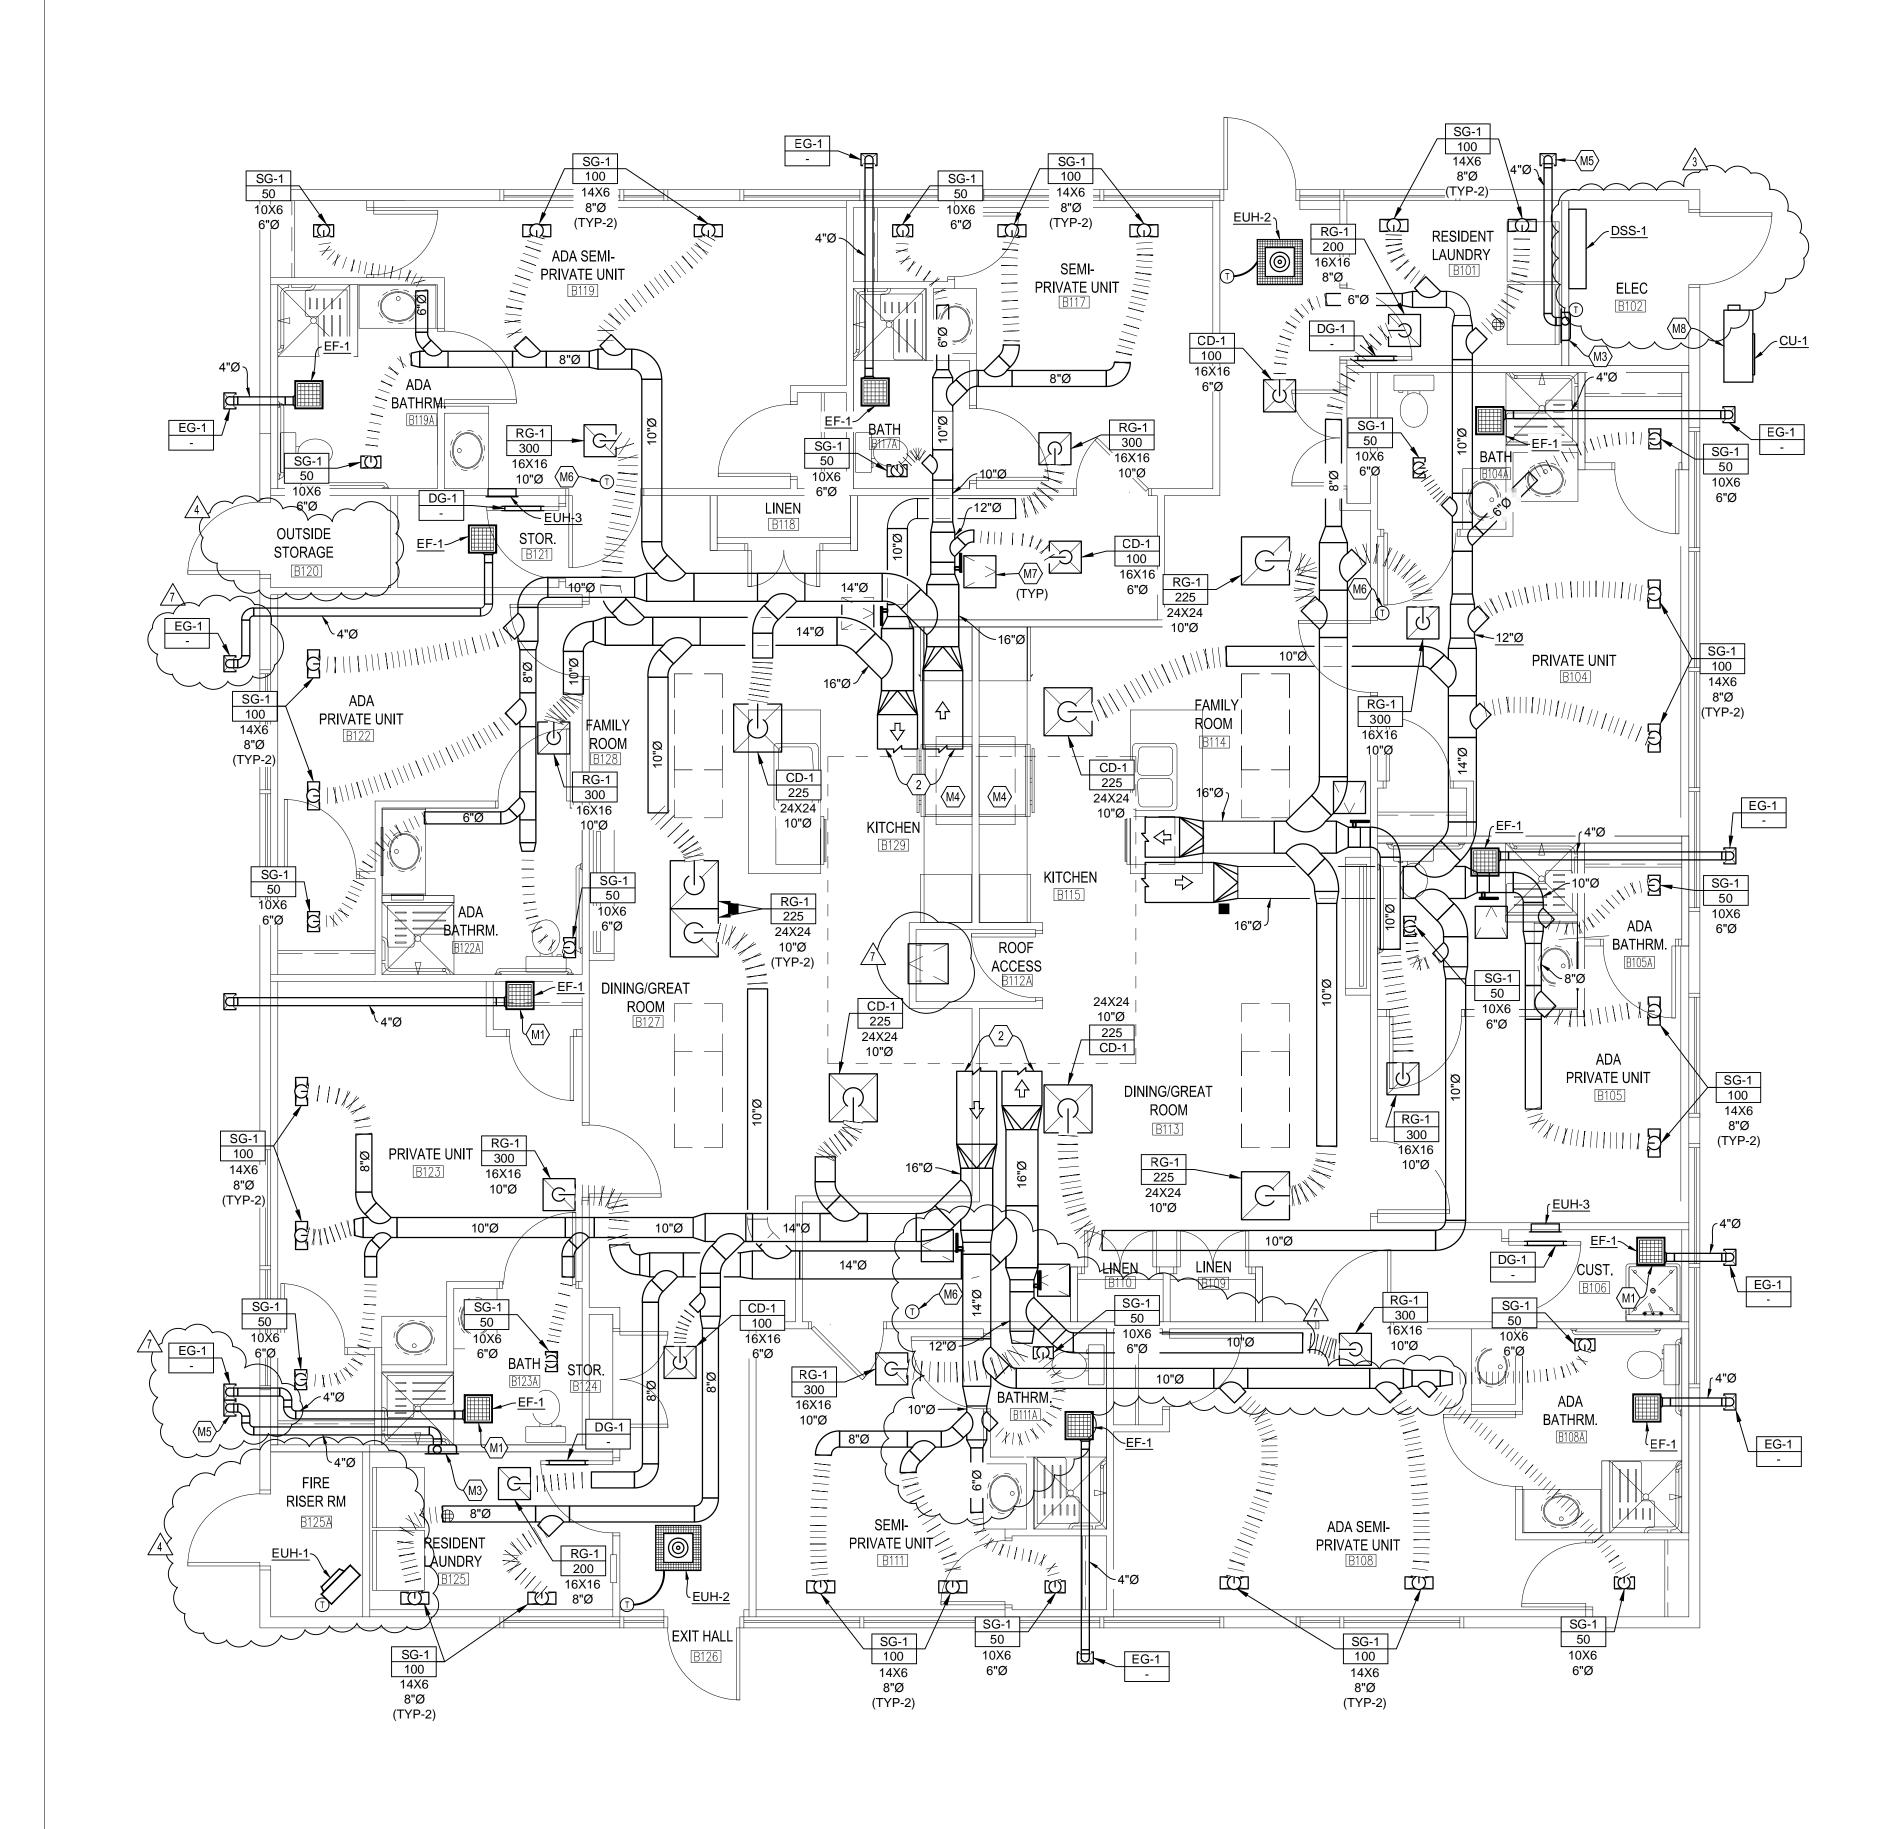


MECHANICAL PLAN-BUILDING 'B' SCALE: 1/4" = 1'-0"

N

	KEYED NOTES	
(M1)	INSTALL EXHAUST FAN AT THIS LOCATION. CONTINUE EXHAUST DUCT TO TERMINATE AT UNDERSIDE OF BUILDING OVERHANG AS INDICATED. COORDINATE LOCATION WITH OVERHEAD PLUMBING.	
M2	SEE ROOF PLAN FOR CONTINUATION OF SUPPLY AND RETURN AIR DUCTWORK.	
M3	LOCATION OF RECESSED DRYER VENT BOX. CONTINUE 4"Ø DRYER DUCT TO TERMINATE AT UNDERSIDE OF BUILDING OVERHANG AS INDICATED.	
(M4) (M5)	RE-CIRCULATING KITCHEN HOOD. PROVIDE TERMINATION KIT FOR DRYER EXHAUST AT THIS LOCATION.	
M6	LOCATION FOR DIGITAL THERMOSTAT WITHIN LOCKING ENCLOSURE.	
M7	ACCESS PANEL TO ALLOW FOR ADJUSTMENT TO ABOVE CEILING BALANCING DAMPER.	
M8	LOCATE OUTDOOR CONDENSING UNIT AS REQUIRED. PROVIDE CONCRETE EQUIPMENT PAD AS NECESSARY. SEE EQUIPMENT SCHEDULE FOR NECESSARY ACCESSORIES. CONCEAL ALL REFRIGERANT PIPING.	
	GENERAL NOTES	The des NCLUDIN Graphic Thereof Copied, Exploite The sol Permiss Archite
1.	PROVIDE BALANCING DAMPERS ON ALL GRILLES, REGISTERS, & DIFFUSERS CONNECTED TO A ROOFTOP UNIT. ALLOW FOR ADJUSTMENT BY REMOVAL OF EXHAUST GRILLES OR BY	THESE D LIMITED CONSULT AGENCIE DNLY IN
2.	PROVIDING ACCESS PANELS. (TYPICAL) ROUTE SUPPLY AND RETURN AIR DUCTWORK THROUGH STRUCTURE AS REQUIRED. PROVIDE NECESSARY TRANSITIONS TO ALLOW FOR CLEAN PATH THE TERMINAL AIR	
3.	DEVICES. PROVIDE WATER TIGHT SEAL ON ALL DUCTWORK AS IT	COI
4.	PENETRATE EXTERIOR ROOFING/WALL ASSEMBLIES. PROVIDE (R-12 MIN.) INSULATION ON ALL ABOVE CEILING DUCTWORK ROUTED IN UNCONDITIONED SPACE.	, A
5.	COORDINATE LOCATIONS OF CEILING GRILLES, REGISTERS, AND DIFFUSERS WITH OVERHEAD PLUMBING PIPING ROUTING.	
6.	VENTILATION PROVIDED BY RTU ECONOMIZER SET TO 20%	P
7.	ENVIRONMENTAL FANS SHALL NOT TERMINATE CLOSER THAN 3 FEET ADJACENT TO BUILDING OPENINGS.	\mathcal{T}
8.	PROVIDE FIRE-RATED DAMPERS AT ALL CEILING DIFFUSERS AND GRILLES TO MAINTAIN FIRE-RATED ASSEMBLY.	} pro
\searrow		/ T
		49
		Sa
		da
		rev
		4 ADDEN 5 ADDEN 7 ADDEN
		da
		projec
		drawn checke
		tit
		ME PLA
		BU

 $\wedge \sim$



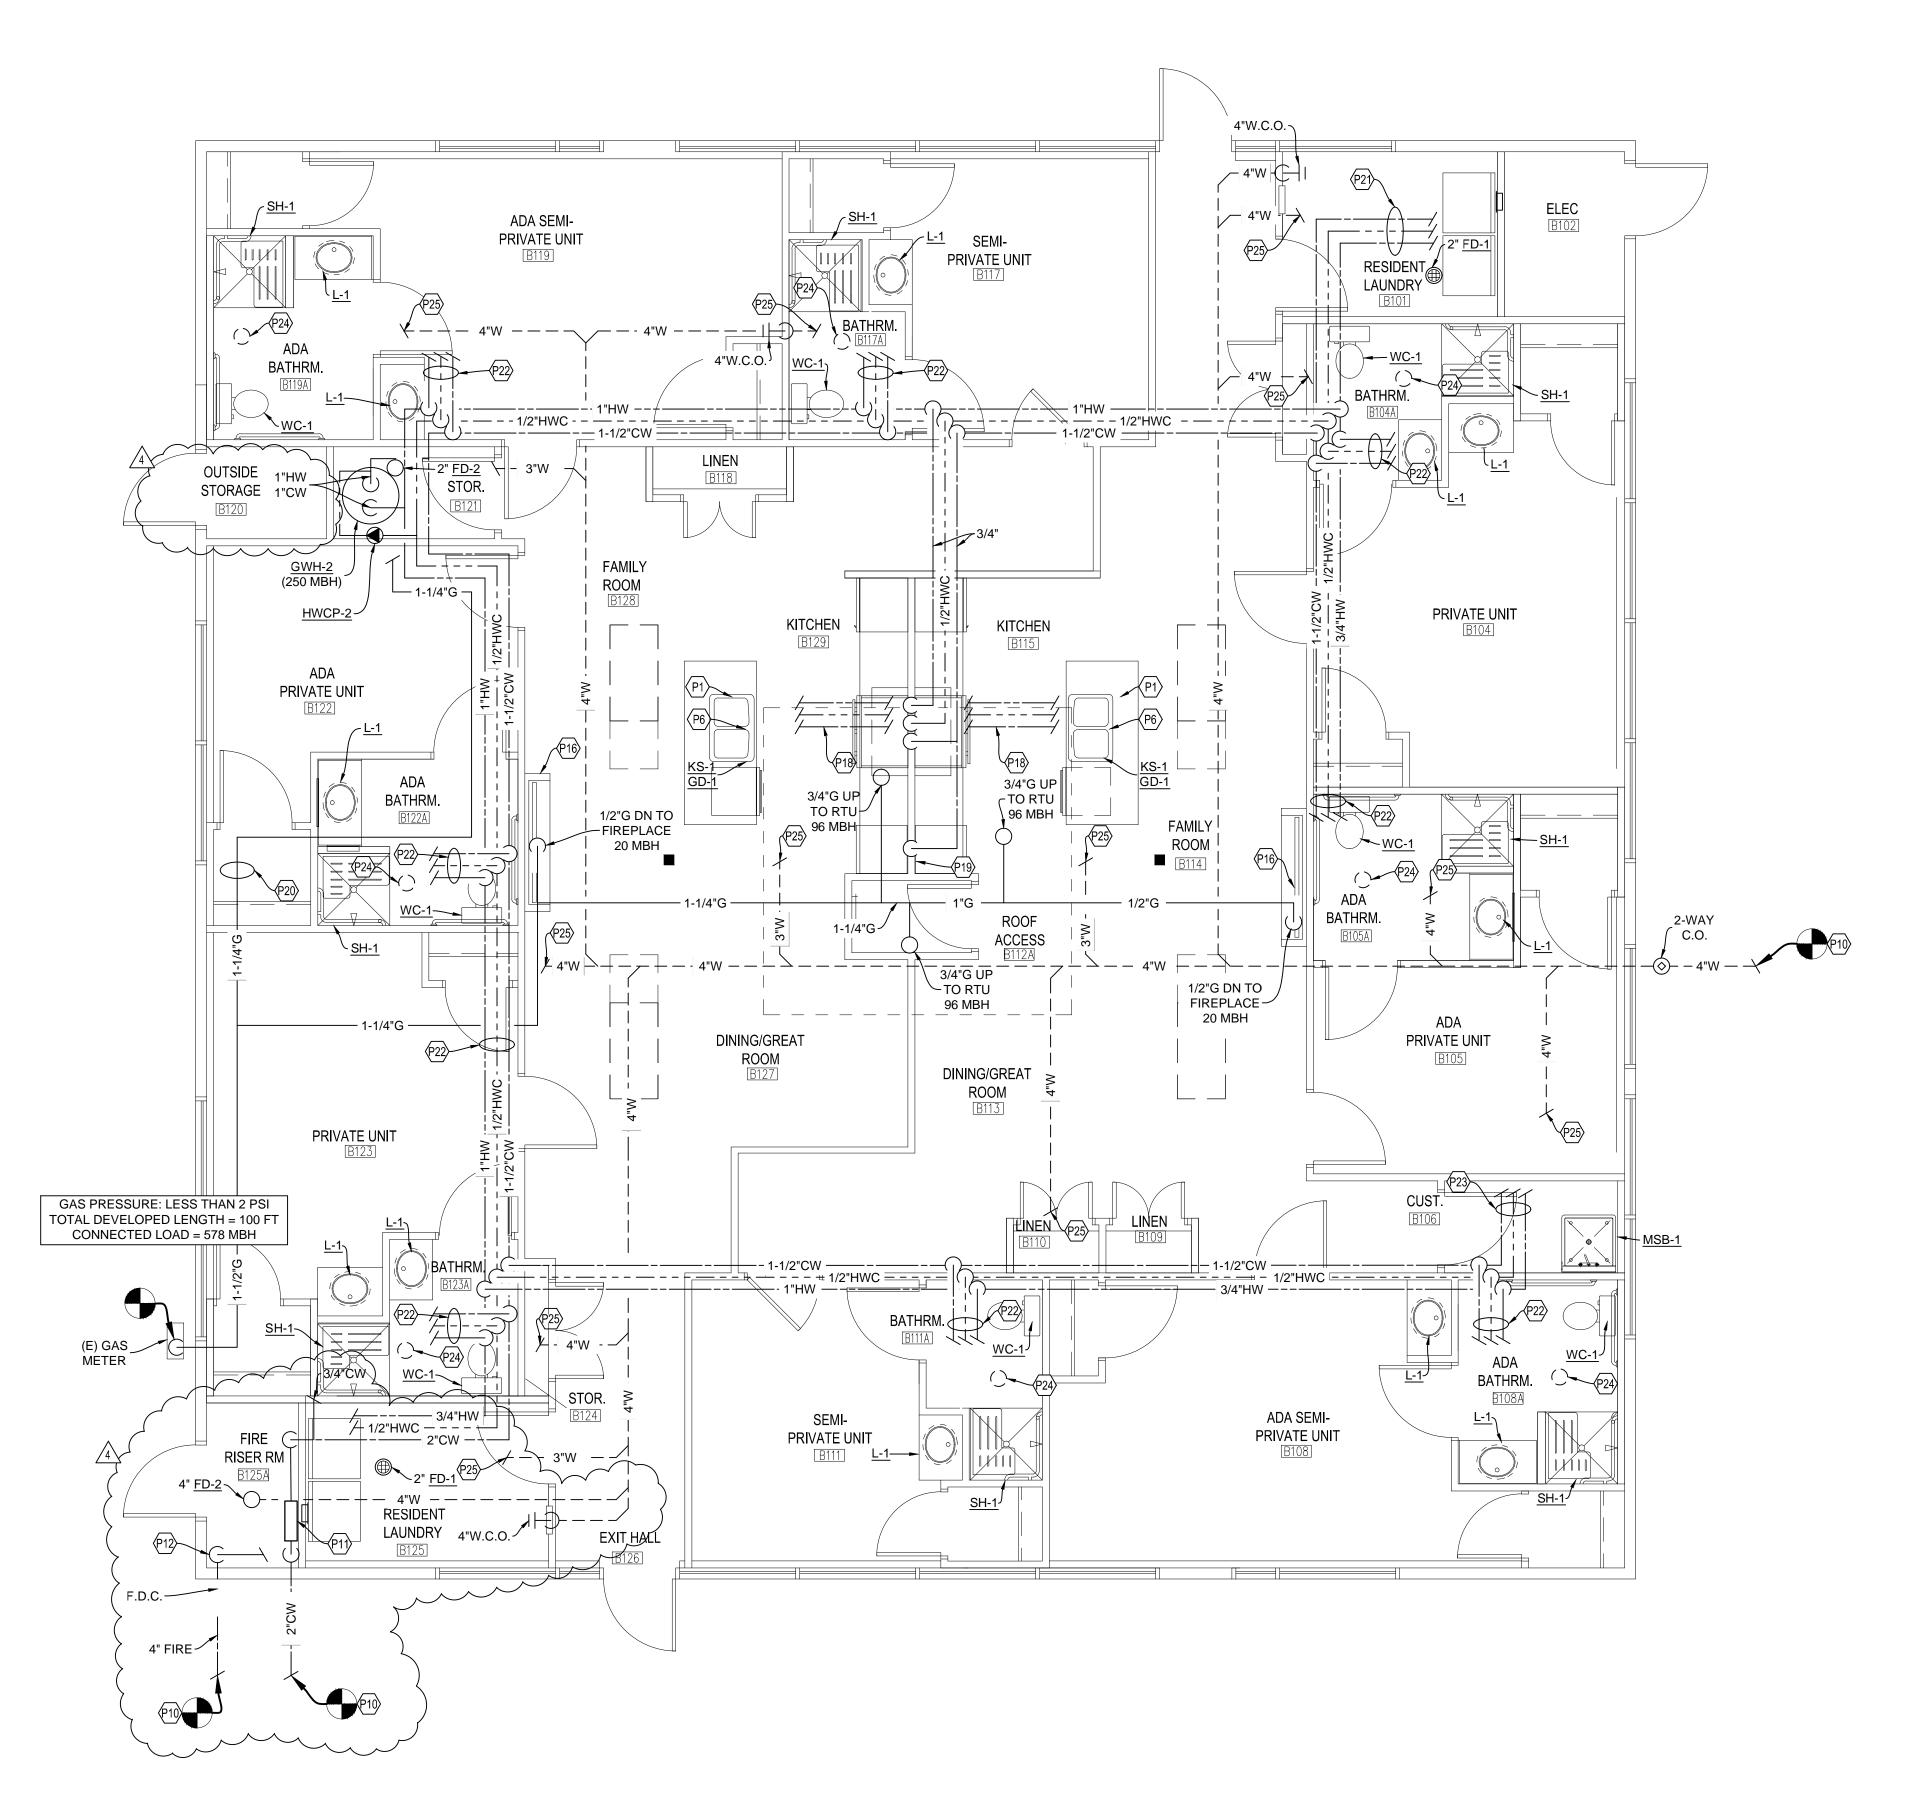

PLUMBING PLAN-BUILDING 'B'

	KEYED NOTES
(P1)	PROVIDE AIR ADMITTANCE VALVE WITHIN CABINETS AT THIS LOCATION. INSTALL PER MANUFACTURER'S RECOMMENDATIONS.
P2	LOCATION OF HOT WATER CIRCULATION PUMP. INSTALL PER MANUFACTURER'S RECOMMENDATIONS. PROVIDE CIRCUIT SETTERS AT FIXTURES AS REQUIRED TO ALLOW FOR HOT WATER CIRCULATION.
P3	NEW WATER HEATER. DIRECT T&P VALVE INTO FLOOR DRAIN. CONTINUE TO NEW FIXTURES AND PROVIDE ISOLATION VALVES AT EACH FIXTURE. PROVIDE GAS LINE ISOLATION VALVE AND SEISMIC BRACING. PROVIDE FLUE AND INTAKE PIPING PER SCHEDULE AND TERMINATE THROUGH ROOF WITH CONCENTRIC VENT KIT.
	NEW URINAL. TIE INTO NEW WASTE, VENT, AND DOMESTIC COLD WATER PIPING. SEE PLUMBING SCHEDULE FOR FIXTURE PIPING SIZES.
$\langle P5 \rangle$	NEW SINK. TIE INTO NEW WASTE, VENT, AND DOMESTIC HOT/COLD WATER PIPING. SEE PLUMBING SCHEDULE FOR FIXTURE PIPING SIZES.
P6	NEW KITCHEN SINK. TIE INTO NEW WASTE, VENT, AND DOMESTIC HOT/COLD WATER PIPING. SEE PLUMBING SCHEDULE FOR FIXTURE PIPING SIZES. PROVIDE RECESSED WALL BOX FOR REFRIGERATOR COLD WATER CONNECTION. PROVIDE HOT WATER CONNECTION TO SERVE DISHWASHER.
(P7)	LOCATION OF NEW WATER CLOSET. PROVIDE WATER, WASTE, & VENT CONNECTION. SEE PLUMBING SCHEDULE FOR FIXTURE PIPING SIZES.
P8	LOCATION OF NEW LAVATORY. PROVIDE WATER, WASTE, & VENT CONNECTION. SEE PLUMBING SCHEDULE FOR FIXTURE PIPING SIZES.
(P9)	LOCATION OF NEW FLOOR DRAIN. PROVIDE WASTE & VENT CONNECTION. SEE PLUMBING SCHEDULE FOR FIXTURE PIPING SIZES.
(P10)	SEE CIVIL PLANS FOR CONTINUATION.
P11	PROVIDE COLD WATER ENTRY WITH BACKFLOW PREVENTER. REFERENCE SHEET P02 FOR DEVICE MAKE/MODEL.
(P12)	PROVIDE 4" FIRE ENTRY DOUBLE CHECK DETECTOR ASSEMBLY. REFERENCE SHEET P02 FOR DEVICE MAKE/MODEL. PROVIDE POWER (115V) FOR RISER MOUNTED COMPRESSOR & PRESSURE SWITCH. REFERENCE SHEET P13 FOR DETAILS. INSTALL COMPRESSOR ABOVE HEIGHT OF DOOR HEADER TO KEEP OUT OF TRAVEL PATH.
P13	PROVIDE 3" VENT THROUGH ROOF.
P14	PROVIDE WALL CLEANOUT AT THIS LOCATION.
P15	PROVIDE GAS LINE WITH VENTLESS REGULATOR AND ISOLATION VALVE. CONNECT TO UNDERSIDE OF NEW RTU. NO ROOF PENETRATION REQUIRED WITH RTU MODEL SPECIFIED.
(P16)	PROVIDE GAS LINE TO FLUELESS DECORATIVE FIREPLACE (20 MBH). INSTALL PER MANUFACTURER'S RECOMMENDATIONS.
(P17)	PROVIDE EMERGENCY FUEL SHUTOFF SWITCH NEAR KITCHEN HOOD. SWITCH TO CLOSE GAS LINE SOLENOID VALVE ASSOCIATED WITH ALL GAS-FIRED APPLIANCES IN KITCHEN.
(P18)	ROUTE 1/2" CW, HW, & HWC LINES BELOW FLOOR TO ISLAND KITCHEN SINK AT THIS LOCATION. EXTEND 1/2" HW LINE TO ADJACENT DISHWASHER.
(P19)	ROUTE CW LINE TO REFRIGERATOR WATER CONNECTION. PROVIDED RECESSED WALL BOX WITH ISOLATION VALVE.
(P20)	PROVIDE PIPING TRANSITIONS UNDER STRUCTURAL BEAM AS REQUIRED. (TYPICAL)
(P21)	ROUTE CW, HW, & HWC LINES TO CLOTHES WASHER WALL BOX. PROVIDE INTEGRAL ISOLATION VALVES AND WATER HAMMER ARRESTOR.
(P22)	ROUTE 1-1/2" CW, 3/4" HW, & 1/2" HWC LINES TO BATHROOM GROUP. PROVIDE HOT AND COLD WATER ISOLATION VALVES AT LAVATORIES.
P23	ROUTE 3/4" CW, 3/4" HW, & 1/2" HWC LINES TO MOP SINK/SINK.
(P24)	COMBINE VENT PIPING FROM BATHROOM FIXTURE AND TERMINATE THROUGH ROOF AT THIS LOCATION. MULTIPLE BATHROOMS GROUPS CAN BE GROUPED TO MINIMIZE ROOFING PENETRATIONS IF NEEDED. ALL VENT THROUGH ROOF PENETRATIONS TO BE 3" MINIMUM.
(P25)	CONTINUE WASTE LINE TO ADJACENT FIXTURE GROUPS. REFERENCE PLUMBING FIXTURE SCHEDULE FOR INDIVIDUAL

